


Kingman

KANSAS

SECTION 17 TOWNSHIP 30S RANGE 8W

WELL NO. #1 Messenger

COMPANY Champlin O&R, etal

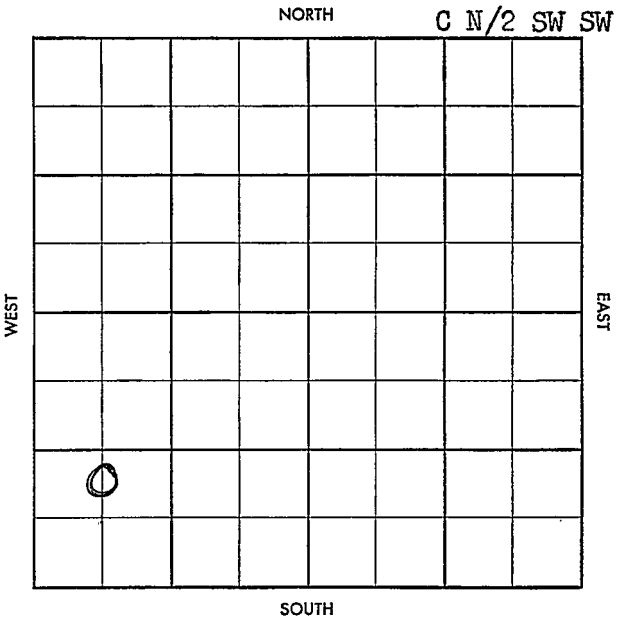



CO. Kingman ELEV. 1533 KB  
SEC. 17 TWP. 30 RGE. 8 WC COMPLETE  
COMPANY Champlin O. & R. NO. 1  
etal

MAR 5 '58

FARM Messenger  
LOC. C N/2 SW SW (-50' W)

H 3237
TR 3250
Dgsh 3274
5d 3297-3393
L 3444
M 4173
TD 4230

GEOL. \_\_\_\_\_  
CONTR. Sierra Drlg.  
POOL Spivey Grabs  
SPUD 1/6/58  
8" @ 255 w/225, WOC  
JAN 15 '58 3544  
JAN 22 '58 DST 4174-93  
120" g 1/2" ga 1.020'  
mef/30 734mef/  
120" 45' Hg 650cm

30' g 650cm 42' 59cm  
BHP 1280/32 fr Log 5" 4226/100  
Log tops H 3237 TR 3254  
Dgsh 3273 LKC 3446  
BKC 3960 Marm 3982.  
Ce 4132 Mchat 4171  
MLi 4203 WOC T JAN 29 '58  
Co 4196 20/4177-87 ga 734mef/30  
10/4172-77 ga 877mef/150'  
750A Frac 10x10 Flo.Ld

+ ga 834mef FEB 5 '58 ga  
1.011mef 1264" chA  
FTP 550 FCP 675  
SITP 975 SICP 1050  
24hrs FEB 12 '58 ga 360mef  
964" chk 17hrs FT.P 600  
FCP 750 SITP 1000  
SICP 1050 FEB 19 '58 FEB 26 '58 MAR 5 '58  
ca op Flo 1.722mef  
GOR 32555 to /

MISS 4172-87