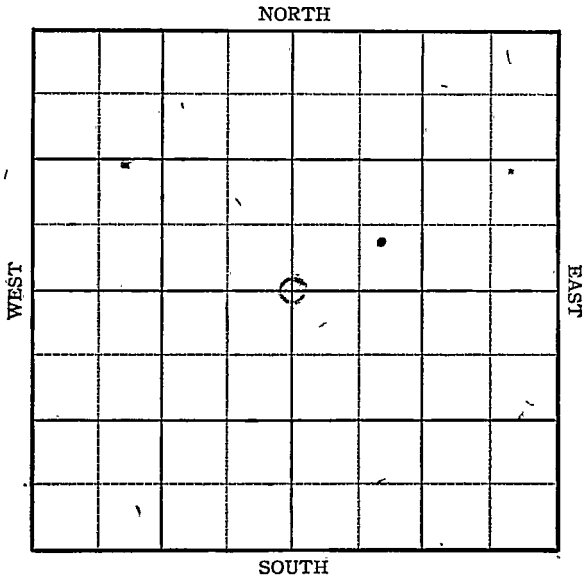


Section 17 Township 30 Range 34WWell No. 1 J. C. StevensCompany Kuhn Bros.

KANSAS

Haskell

Sec. 17 Twp. 30 R. 34W

Well No. 1 J. C. Stevens Farm

Kuhn Bros. Company

Hugoton


2640 Ft. from N. Line

Ft. from S. Line

2640 Ft. from E. Line

Ft. from W. Line

C SEC Elev. 2980

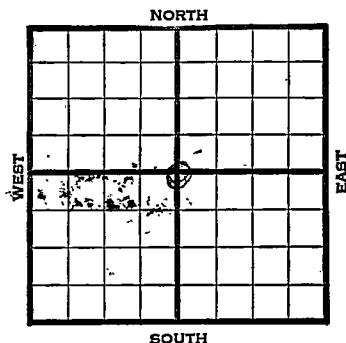

1945

REPORT

Date	Location
6/20	
6/28	"
7/3	"
7/11	"
7/19	Dr1g. 565
7/26	10" @ 570
8/1	Dr1g. 2389
	7" @ 2537
	TD 9540 RUST
8/8	TD 2672 1 1/2 M Gas
8/15	TD 2732
	223' of 5" perf. liner @ 2732 WOC
8/22	" " " " " "
8/29	" " " " " "
9/5	13000 acid
9/12	" "
9/19	" "
9/26	7" @ 2537
	223' of 5" Perf. liner @ 2732
	13000 acid.
	TD 2732'
	29,343,000 Gas.
	423# R Pr.

COMPLETED

Kansas Pool Name HugotonMap No. no map Sec. 17 Twp. 30 R. 34WWell No. 1 J. C. StevensKuhn Bros.


Company

FIRST REPORT

Contractor

C Sec.

SECTION FLAT

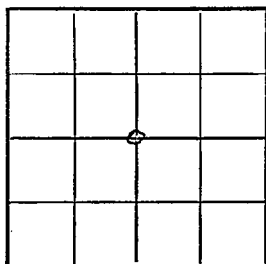2640 Ft. from N. Line Ft. from S. Line2640 Ft. from E. Line Ft. from W. LineHaskell CountyLocation XRig up

Drilling and Remarks:

RECORD

Cased in., ft.Sand Gas Oil Total Depth

PRODUCTION

1st 24 hrs. Nat. 1st 24 hrs. after shot Gas Cu. Ft.Dry Hole Abandoned

Date

JUN 20 1945 19S. J. LEWIS

Scout


KANSAS Kansas Pool Name HugotonMap No. no map Sec. 17 Twp. 30 R. 34WWell No. 1 J. C. StevensKuhn Bros.

Company

COMPLETED

Contractor

C Sec.

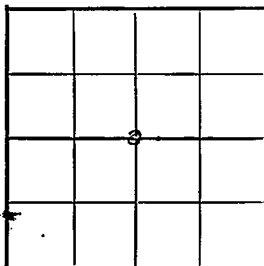E1-2880
SECTION PLAT2640 Ft. from N. Line Ft. from S. Line2640 Ft. from E. Line Ft. from W. LineHaskell County

Location

Rig up

Drilling and Remarks:

7" @ 2537223' x 5" by hand@ 273213000 acid29,343,000 Gas423" R P**RECORD**Cased in., ft.Sand Gas Oil Total Depth 2732**PRODUCTION**1st 24 hrs. Nat. 1st 24 hrs. after shot Gas Cu. Ft.Dry Hole Abandoned

Date

SEP 26 1945S. J. LEWIS

Scout