
Sumner **KANSAS**

SECTION 17 TOWNSHIP 30 RANGE 2 W

WELL NO. #1 Johnson

COMPANY McNeish & Garlapp

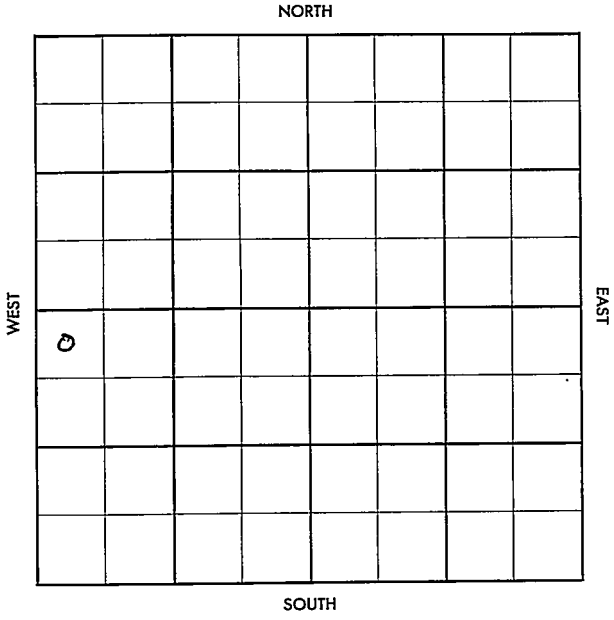

Sumner KANSAS

SEC.	TWP.	R.
17	30	2W

WELL NO.

#1 Johnson FARM

COMPANY

McNeish & Gralapp

CONTRACTOR

WILDCAT


_____ Ft. from N. Line

_____ Ft. from S. Line

_____ Ft. from E. Line

_____ Ft. from W. Line

NW NW SW

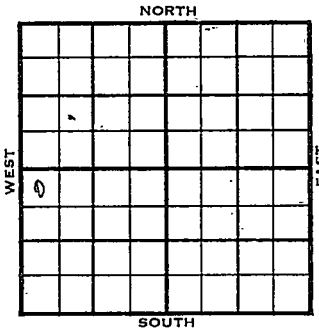

1955	ELEVATION 1358'	REPORT
12-21	RUR	
1956		
1-11	Comm. 12-27-55 8 5/8" @ 318/250 KC. 3101 M. 3727 TD 3834'	
		ABANDONED

DX-78

FORM 513 REV. SUNRAY

County Sumner Elev.

Sec. 17 Twp. 30 Rge. 2W

Company McNeish & Gralapp

Farm Name Johnson No. 1

TOPS	DEPTH	LOG	DATUM
Anh.			
T.P.			
H.			
Tr.			
Dg.			
B.L.			
L.			
K.C.			
B.K.C.			
Ce.			
C.			
M.			
M.			
K.			
Mz.			
Mg.			
V.			
S.			
S.			
A			
R.			
P€.			
G.			
T.D.			

Loc. in Sec. NW NW SW

Geol.

Contr.

Pool Wildcat

FIRST REPORT
DEC 21 '55

Date Comm.
R U R

Co. Lse. No. Sec. T. R.

FORM 513 REV. SUNRAY

County Sumner Elev. 1358

Sec. 17 Twp. 30 Rge. 2W

Company McNeish & Gralapp

Farm Name Johnson No. 1

TOPS	DEPTH	LOG	DATUM
Anh.			
Tp.			
H.			
Tr.			
Dg.			
Bl.			
L.			
K.C.	3101		1743
B.K.C.			
Ce.			
C.			
M.	3727		2369
M.			
K.			
Mz.			
Mo.			
V.			
S.			
S.			
A			
R.			
P€.			
G.			
T.D.	3834		

Loc. in Sec. NW NW SW

Geol.

Contr.

Pool Wildcat

ABANDONED

Date Comm. 12-27-55 JAN 1 1 1956

8 5/8" @ 318/250

D & A

Co. Lse. No. Sec. T. R.