


Section 17 Township 30 Range 2W

Well No. #1 - Shinn

Company Turpin et al

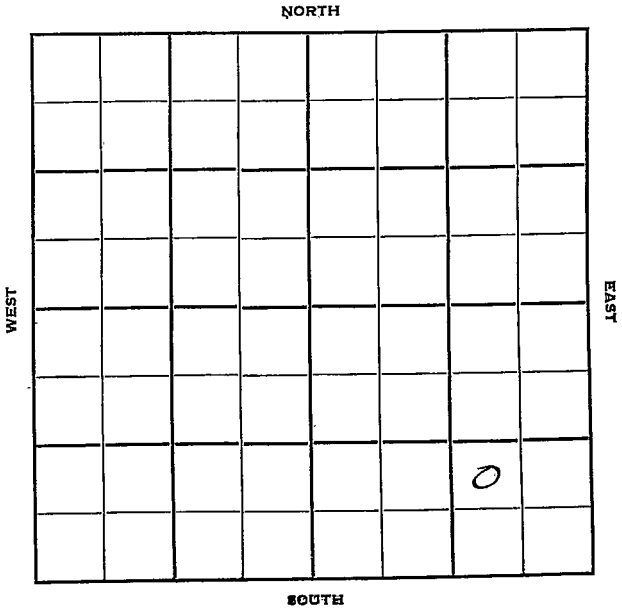

Summer

KANSAS

Sec. 17 Twp. 30 R. 2W

Well No. #1 Shinn- Farm

Turpin et al Company

Contractor

Latta Pool


Ft. from N. Line

990' Ft. from S. Line

990' Ft. from E. Line

Ft. from W. Line

NW SE SE

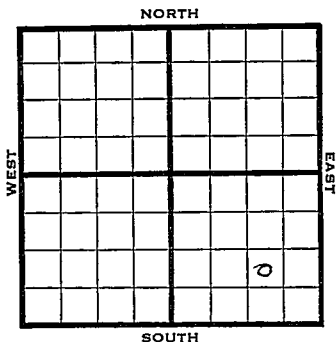

1950

Elev 1343'

REPORT

3/15

RUR

3/29

KC 3087'

TD 3296'

D&A

Aband.

**ABANDONED**

Kansas

Map No. \_\_\_\_\_ Sec. 17 Twp. 30 R. 2W

Well No. 1 Shinn

Turpin et al. \_\_\_\_\_ Company

Contractor

NW SE SE

## SECTION PLAT

\_\_\_\_\_ Ft. from N. Line

990 Ft. from S. Line

990 Ft. from E. Line

\_\_\_\_\_ Ft. from W. Line

			o

Sumner County

Location \_\_\_\_\_

Rig up \_\_\_\_\_

Drilling and Remarks:

R U R

## RECORD

Cased \_\_\_\_\_ in., \_\_\_\_\_ ft.

Sand \_\_\_\_\_

Gas \_\_\_\_\_

Oil \_\_\_\_\_

Total Depth \_\_\_\_\_

## PRODUCTION

1st 24 hrs. Nat. \_\_\_\_\_

1st 24 hrs. after shot \_\_\_\_\_

Gas \_\_\_\_\_ Cu. Ft.

Dry Hole \_\_\_\_\_

Abandoned \_\_\_\_\_

Date

MAR 15 1950 19

J. E. TYRA Scout

Map No. \_\_\_\_\_ Sec. 17 Twp. 30 R. 2WWell No. 1 Shinn\_\_\_\_\_ Turpin etal. \_\_\_\_\_ Company

\_\_\_\_\_ Contractor

N<sup>W</sup> SE SEE1. 1343

SECTION PLAT

\_\_\_\_\_ Ft. from N. Line

990 Ft. from S. Line990 Ft. from E. Line

\_\_\_\_\_ Ft. from W. Line

Summer County

ABANDONED			
			○

Location \_\_\_\_\_

Rig up \_\_\_\_\_

Drilling and Remarks:

K.C. 3087T.D. 3296D & A

## RECORD

Cased \_\_\_\_\_ in., \_\_\_\_\_ ft.

Sand \_\_\_\_\_

Gas \_\_\_\_\_

Oil \_\_\_\_\_

Total Depth \_\_\_\_\_

## PRODUCTION

1st 24 hrs. Nat. \_\_\_\_\_

1st 24 hrs. after shot \_\_\_\_\_

Gas \_\_\_\_\_ Cu. Ft.

Dry Hole \_\_\_\_\_

Abandoned \_\_\_\_\_

Date

MAR 29 1950<sub>19</sub>J. E. TYRA

Scout