

KANSAS

Grant

Section 17 Township 30 Range 37W

Well No. 1 Henderson

Company Hugoton Prod.

Hugoton
NORTH

WEST

			0				

EAST

SOUTH

Grant 30

KANSAS

Sec. 17 Twp. 30 R. 37W ✓

Well No. #1 Henderson Farm

Hugoton Prod.

Company

Hugoton Pool (Burris, Cont.)


100' Ft. from N. Line

Ft. from S. Line

100' Ft. from E. Line

Ft. from W. Line

NE SW

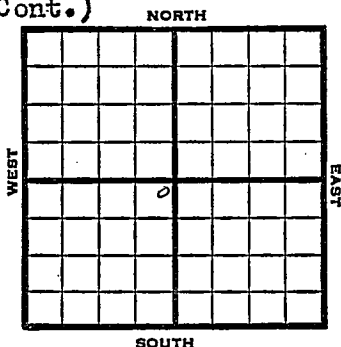

1949

Lev 3112' REPORT

6/8	Location
6/15	10" @ 600'
6/21	TD 2450'
	7" @ 2442'
6/28	Drlg. 2536'
7/6	"
7/12	"
7/20	"
7/27	Drlg 2611'
8/3	TD 2679'
	257' of 5" Perf liner @ 2679'
8/10	7" @ 2442'
	257' of 5" Perf Liner
	2,070,000 Gas
	427# R.Pr. 3 1 1 1 1 1
	Comp

COMPLETED

Grant County Kansas State

Map No. _____ Sec. 17 Twp. 30 R. 37W

Well No. 1 Henderson

Hugoton Prod. Company

Burris Contractor

NE SW

FIRST REPORT SECTION PLAT

100 Ft. from N. Line

_____ Ft. from S. Line


100 Ft. from E. Line

_____ Ft. from W. Line

Hugoton Pool

Remarks:

Location

 

Date JUN 8 1949

Scout S. J. LEWIS

Map No. 1 Sec. 17 Twp. 30 R. 37W

Well No. 1 Henderson

Hugoton Prod. Company

COMPLETE

Contractor

NE SW


E. 31/2
SECTION PLAT

100 Ft. from N. Line

_____ Ft. from S. Line

100 Ft. from E. Line

_____ Ft. from W. Line

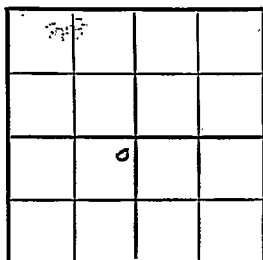

Grant County

RECORD

Location _____

Cased _____ in., _____ ft.

Rig up _____

Sand _____

Drilling and Remarks:

Gas _____

7" Co 2 4 4 2

Oil _____

Total Depth _____

2 3-7' 2 1/2" Ref. line

PRODUCTION

2, 070, 000 lbs

1st 24 hrs. Nat. _____

1st 24 hrs. after shot _____

Gas _____ Cu. Ft.

Dry Hole _____

Abandoned _____

427# R/L

Date

AUG 10 1949 19

S. J. LEWIS

Scout