


Section 18 Township 30 Range 31 WWell No. # 1 Homer UnitCompany Helmerich & Payne

NORTH

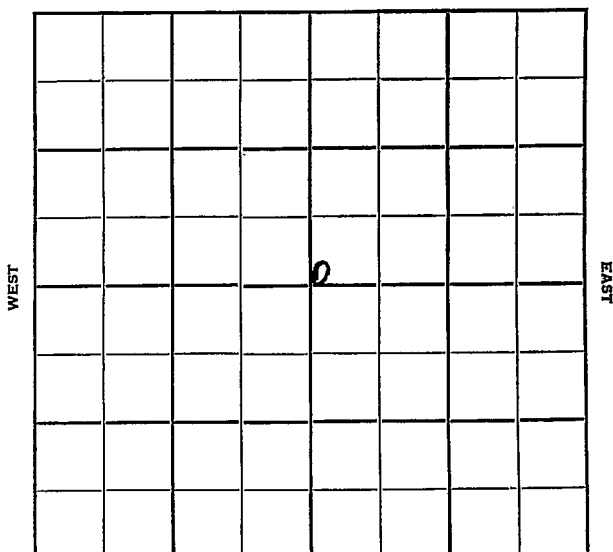

SOUTH

Haskell.


KANSAS

Sec. 18 Twp. 30 R. 31WWell No. #1 Hommer Unit FarmHelmerich & Payne Company

Contractor

 Ft. from N. Line150 Ft. from S. Line Ft. from E. Line150 Ft. from W. Line

SW SW NE

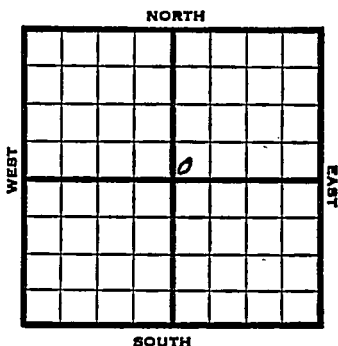

1953

Elev. 2850' REPORT

6/17 Drlg.

6/24 10" @ 657

RTD 2703

7" @ 2650

Her 2646, Kr 2680

7/1 CO 2703' 1000 A 198,000 gas & 10
GWPH 5000 A 760,000 & 20 GWPH

7/8 DD 2710 6000 A

7/22 48/ 2620-28

54/ 2635-44 5000 A 60 gw 15,000 A

7/29 NR

8/26 "

9/9 "

9/23 Spud 6-13-53 Gas well TD 2710

10" @ 657 7" @ 2650 Her. 2646

Kri. 2680 TD 2703 CO to 2703

1000 A 198,000 gas, 10 GWPH

5000 A 760,000 gas 20 GWPH

DD 2710 6000 A 48/2620-28


54/2635-44 5000 A 60 GW

15000 A Win. 2682'

Comp. 5,172,000 gas. 408#

COMPLETED

County Haskell State Kansas
 Sec. 18 (Blk. 30) (Sur. 31W) (Twp. Map No.)
 Operator Helmerich & Payne
 Well No. 1 Farm Hoover Unit
 Elev. 2850 Location SW SW NE

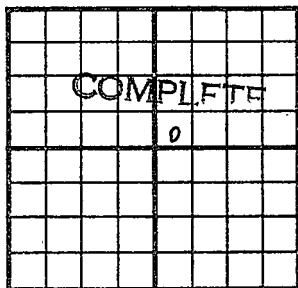

550 Ft. From S Line NE
150 Ft. From W Line Quarter

1st. Report

Completion SEP 23 1952

Remarks

Spudding Date 6-13-53

Drlg. Data Gas well TD 2710

10" @ 657 7" @ 2650 Her. 2646

Kri. 2680 TD 2703 CO to 2703 1000 A

198,000 gas 10 gwph 5000 A

760,000 gas 20 gwph DD 2710 6000 A

48/ 2620-28 54/ 2635-44 5000 A

60 gw 15000 A Win. 2682

Comp. 5,172,000 gas 408#