

KANSAS


Grant

FORM 51 5M 11-44 PETROL

Section 18 Township 30 Range 36W

Well No. 1 Blake

Company United Prod.

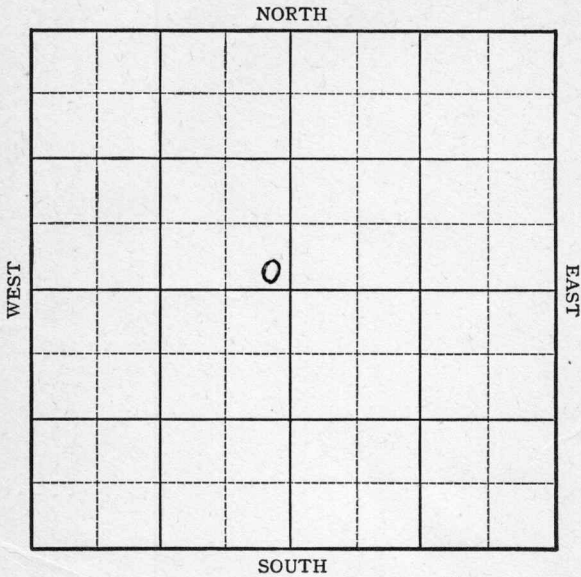

KANSAS

Grant County

Sec. 18 Twp. 30 R. 36WWell No. #1 Blake FarmUnited Prod. Company

Hugoton

Ft. from N. Line

100


Ft. from S. Line

100

Ft. from E. Line

Ft. from W. Line

SE NW

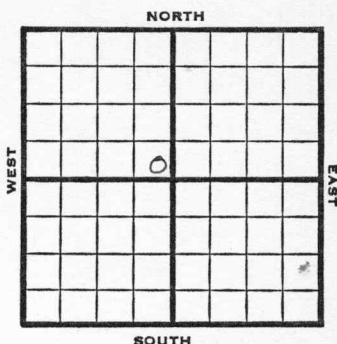

1946

REPORT

Elev. 3004

5/1

10" @ 593

Drlg. 600'

5/7

Drlg 900'

5/14

TD 2737

7" @ 2737 R^UST

5/21

" " "

5/29

" " "

6/5

336 shots 2444-2706

22,000 acid.

6/12

" " "

6/18

" " "

6/26

" " "

7/3

7" @ 2737

Perf.

22,000 acid.

TD 2737'

12,100,000 Gas.

410# R Pr.

COMPLETED

Kansas Pool Name HugotonMap No. 10 map Sec. 18 Twp. 30 R. 36WWell No. 1 BlakeUnited Prod.


Company

CORRECTION& first report

Contractor

SE NW

SECTION PLAT

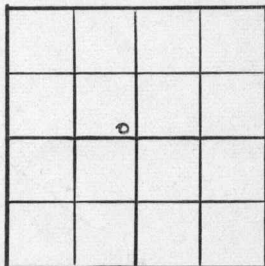

Ft. from N. Line

100

Ft. from S. Line

100

Ft. from E. Line

Ft. from W. Line

Grant County

Location

Rig up

Drilling and Remarks:

Reported

SW NW

RECORD

Cased _____ in., _____ ft.

Sand _____

Gas _____

Oil _____

Total Depth _____

PRODUCTION

1st 24 hrs. Nat. _____

1st 24 hrs. after shot _____

Gas _____ Cu. Ft.

Dry Hole _____

Abandoned _____

Date

MAY 1 1946 19S. J. LEWIS Scout

KANSAS

Kansas Pool Name Hugoton PoolMap No. map Sec. 18 Twp. 30 R. 36WWell No. 1 BlakeUnited Prod. Company**COMPLETED**

Contractor

SE NW

E13004

SECTION PLAT

100 Ft. from N. Line100 Ft. from S. Line100 Ft. from E. Line Ft. from W. LineGrant CountyLocation Rig up

Drilling and Remarks:

7" @ 2787

Perf.

22000 acid

12, 100, 000 Gall

410 # RB

RECORDCased in., ft.Sand Gas Oil Total Depth 2787**PRODUCTION**1st 24 hrs. Nat. 1st 24 hrs. after shot Gas Cu. Ft.Dry Hole Abandoned

Date

JUL 3 1946

19

S. J. LEWIS

Scout