
FORM 51 10M 8-47

KANSAS Grant

Section 18 Township 30 Range 35-W

Well No. #1 Jennings

Company United Prod

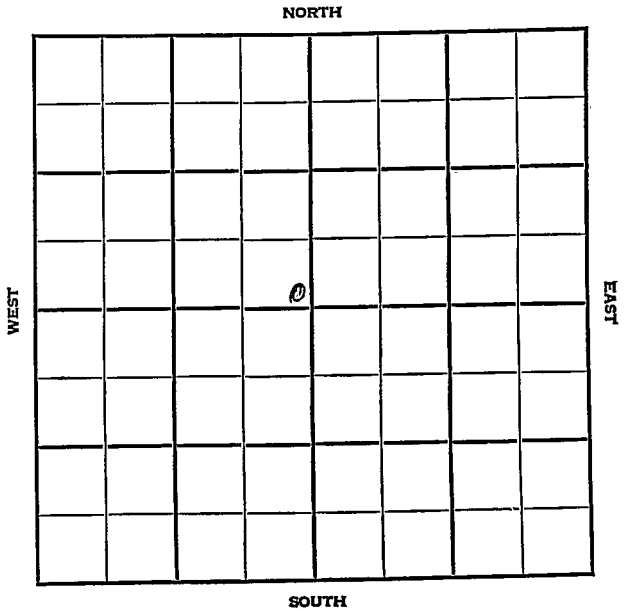

FORM 252-A
5M 4-48 PETROL


KANSAS Grant ✓

Sec. 18 Twp. 30 R. 35W

Well No. #1 Jennings Farm

United Prod. Company

Hugoton Pool

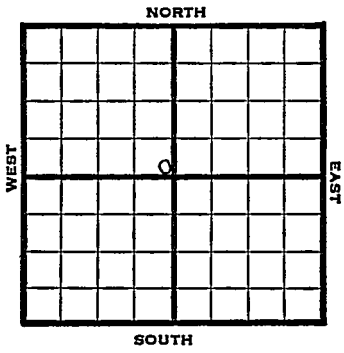

____ Ft. from N. Line

100' Ft. from S. Line

100' Ft. from E. Line

____ Ft. from W. Line

SE NW

1948	Eli 3014' REPORT
6/23	Location
6/29	10"@ 563' TD 2550 7"@ 2549' RUST
7/8	17000 acid Drlg 2720
7/14	TD 2745' 206' of 5" Perf Liner @ 2745 2000 acid
7/21	12000 acid
7/28	"
8/4	7"@ 2549' 206' of 5" Perf liner @ 2765' TD 2765 12000 acid 14,825,000 gas 422 # R Pr. Comp COMPLETED

Form 26—200 Bks.—1-48—Palace

Kansas

Hugoton Pool

Map No. _____ Sec. 18 Twp. 30 R. 35W


Well No. 1 Jennings

United Prod. Company

FIRST REPORT Contractor

SE NW

SECTION PLAT

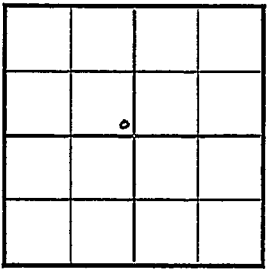

_____ Ft. from N. Line

100 Ft. from S. Line

100 Ft. from E. Line

_____ Ft. from W. Line

Grant County

Location X

Rig up

Drilling and Remarks:

RECORD

Cased _____ in., _____ ft.

Sand

Gas

Oil

Total Depth

PRODUCTION

1st 24 hrs. Nat.

1st 24 hrs. after shot

Gas _____ Cu. Ft.

Dry Hole

Abandoned

Date

JUN 23 1948 19 S. J. LEWIS Scout

Form 27—100 Bks.—4-48—Petrol

Grant County Kansas State

Map No. Sec. 18 Twp. 30 R. 35W

Well No. 1 Jennings


United Prod. Company

COMPLETE Contractor

SE NW

E 1.3014

SECTION PLAT

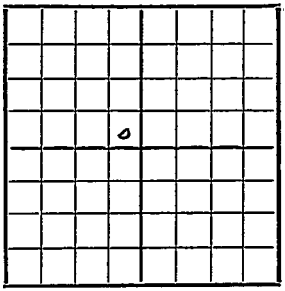

Ft. from N. Line

100 Ft. from S. Line

100 Ft. from E. Line

Ft. from W. Line

Hugoton Pool

Remarks:

7" @ 2549

206' of 5" Perf liner @ 2765

TD 2765'.

12000 gal acid

14,825,000 Gas

422# RP

Date AUG 4 1948

Scout S. J. LEWIS