KANSAS

Grant


FORM 51 10M 8-47

Section 18 Township 30 Range 35W

Well No. #1 Jennings

Company United Prod.

Hugoton Pool

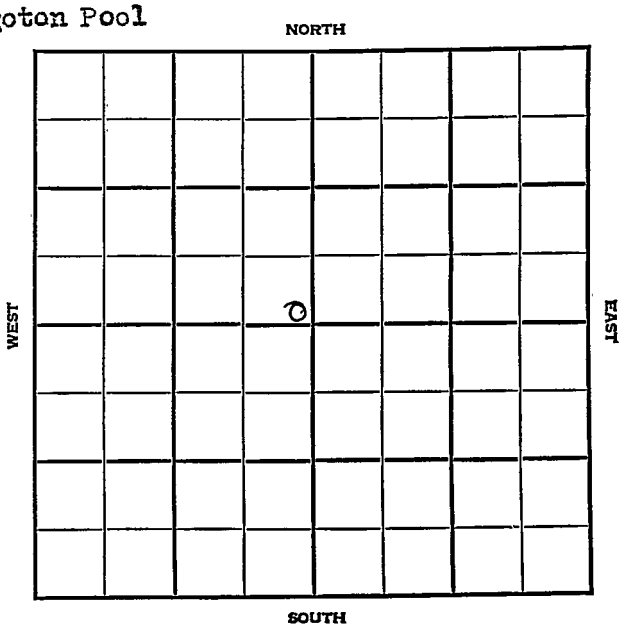

FORM 252-A
5M 9-47 PETROL

KANSAS Grant ✓

Sec. 18 Twp. 30 R. 35W

Well No. #1 Jennings Farm

United Prod. Company

Hugoton Pool


_____ Ft. from N. Line

100' Ft. from S. Line

100' Ft. from E. Line

_____ Ft. from W. Line

SE NW

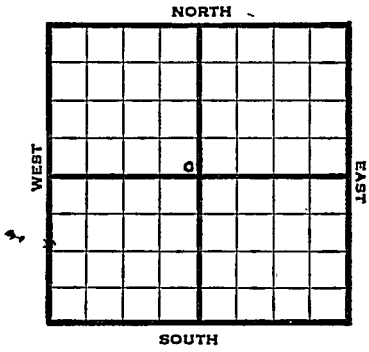

1948	REPORT
	Elev. 3014'
2/11	Location
2/18	"
2/25	"
3/3	"
3/10	"
3/17	"
3/24	" ABANDONED

Form 26 200 Bks. 10-46 Petrol Kansas

Hugoton Pool

Map No. ____ Sec. 18 Twp. 30 R. 35W


Well No. 1 Jennings

United Prod. Company

FIRST REPORT Contractor

SE NW

SECTION PLAT

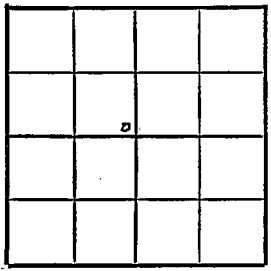

____ Ft. from N. Line

100 Ft. from S. Line

100 Ft. from E. Line

____ Ft. from W. Line

Grant County

Location x

Rig up

Drilling and Remarks:

RECORD

Cased ____ in., ____ ft.

Sand

Gas

Oil

Total Depth

PRODUCTION

1st 24 hrs. Nat.

1st 24 hrs. after shot

Gas ____ Cu. Ft.

Dry Hole

Abandoned

Date

FEB 11 1948 19

S. J. LEWIS Scout

Form 26—200 Bks.—1-48—Palace

Hugoton Pool

Kansas

Map No. No Map Sec. 18 Twp. 30 R. 35W

Well No. 1 Jennings


United Prod. Company

ABANDONED Contractor

SE NW

E 63014

SECTION PLAT

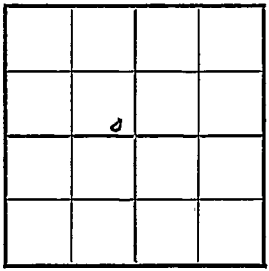

____ Ft. from N. Line

100 Ft. from S. Line

100 Ft. from E. Line

____ Ft. from W. Line

Grant County

Location ✓

Rig up

Drilling and Remarks:

RECORD

Cased ____ in., ____ ft.

Sand

Gas

Oil

Total Depth

PRODUCTION

1st 24 hrs. Nat.

1st 24 hrs. after shot

Gas ____ Cu. Ft.

Dry Hole

Abandoned

Date

MAR 24 1948 19

S. J. LEWIS Scout