


Section 18 Township 30 Range 33W

Well No. 1 Anton gas unit "A"

Company Stanolind

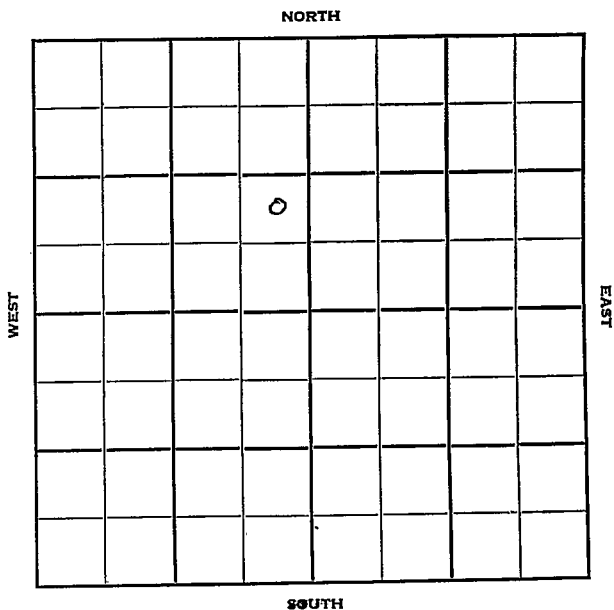


Haskell

KANSAS

Sec. 18 Twp. 30 R. 33W

Well No. #1 Anton Gas Unit "A" Farm _____
Stanolind Company _____
 Contractor _____

_____ Ft. from N. Line
1025' Ft. from S. Line
150' Ft. from E. Line
 _____ Ft. from W. Line

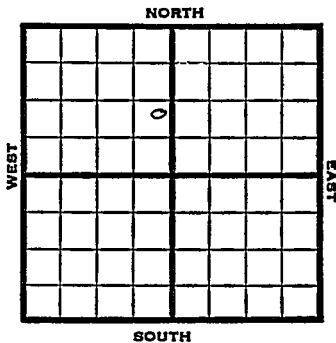

NE SE NW

1951	Elev. 2955' REPORT
7/18 8/15	Spud 7-12-51 10" @ 724 Drlg. 2170' Spud 7-12-51 Gas Well TD 2783 10" @ 724 Hol. 2572 Her. 2605 Krider 2646 Win. 2676 Ft. Riley 2725 TD 2783 7" @ 2776 36/2610-26 18/2643-46 30/2654-59 78/2670-83 48/2696-2704 48/2710-18 17000 A Comp. 14,490,000 gas 405# <p style="text-align: center;">COMPLETED</p>

County Haskell State Kansas

Sec. 18 (Blk. Twp.) 30 (Sur. Rge.) 33W Map No.

Operator Stanolind

Well No. 1 Farm Anton gas unit "A"

Elev. Location NE SE NW

		0			

1025 Ft. From S Line NW

150 Ft. From W Line Quarter

Ist. Report JUL 18 1951

Completion

Remarks

Spudding Date 7-12-51

Drlg. Data

10" @ 724 drlg. 2170

J. E. TYRA

