


Section 19 Township 30 Range 11 W

Well No. #1 Wulf

Company O. H. Parker

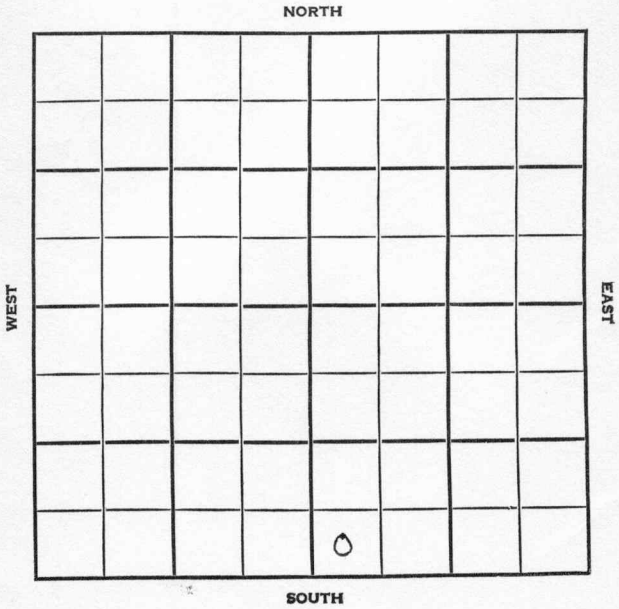

Barber

SEC.	TWP.	R.
19	30	11W

WELL NO.

#1 Wulf

FARM

COMPANY

O. H. Parker

CONTRACTOR

Gabbert-Jones

Wildcat


_____ Ft. from N. Line

_____ Ft. from S. Line

_____ Ft. from E. Line

_____ Ft. from W. Line

SW SW SE

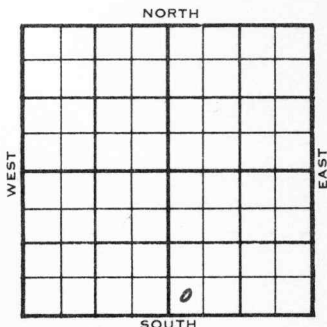

Amerada & Skelly DHM

1955	ELEVATION	REPORT
	1826 DF	
8/17	MIR	
8-25	Spud 8-18-55, 8 5/8" @ 402/300, Ft. Riley 1775, drlg. 2130'	
9-2	Top: 3411, Elgin sd. 3626, Doug. sd 3784 DST 3774-89, open 1 hr., rec. 250' msw, 1420#, drlg. 3886	
9-8	DST 3626-60, open 1 hr., rec. 105'wm, 1300/30", DST 4428-40, open 2 hr., rec. 270' gas, 90' gc & socm, 150' O&GCM, 680/30", DST 4440-50	
9-14	DST 4440-55 op 2 hrs. rec. 100' mud D & A Tops: Br. Ls 3919 Lsg. 3929 M. 4428 T.D. 4530'	
		ABANDONED

County Barber Elev. _____
 Sec. 19 Twp. 30 Rge. 11W
 Company O. H. Parker
 Farm Name Wulf No. 1

TOPS	DEPTH	LOG	DATUM
Anh.			
TP.			
H.			
Tr.			
Dg.			
BL.			
L.			
K.C.			
B.K.C.			
Ce.			
C.			
M.			
M.			
K.			
Mz.			
Ma.			
V.			
S.			
S.			
A.			
R.			
PE.			
G.			
T.D.			

Loc. in Sec. SW SW SE

Geol. _____

Contr. Gabbert-Jones

Pool Wildcat

1/2 mile
FIRST REPORT
AUG-17 '55
0

Date Comm. Amerada & Skelly - DHM
M I R

Handwritten signature/initials

Co.

Use

No.

Sec.

T.

R.

County Barber Elev. 1826 DF
 Sec. 19 Twp. 30S Rge. 11W
 Company O. H. Parker
 FarmName Wulf No. 1

TOPS	DEPTH	LOG	DATUM
Anh.			
Top			
H ¹ Riley	1775		1551
Top	2411		1585
D ¹ Ig. Sd.	3626		1800
B ¹ Dg. Sd.	3784		1958
X ¹ Br. Ls.	3919		2093
X ² Lsg.	3929		2103
B.K.C.			
Ce.			
C.	4428		2602
M.			
M.			
K.			
Mz.			
Ma.			
V.			
S.			
S.			
A.			
R.			
PE.			
G.			
T.D.	4530		

Loc. in Sec. SW SW SE
 Geol. _____
 Contr. Gabbert-Jones
 Pool W.C.



Date Comm. 8-18-55 SEP 14 1955
8-5/8" 402 w/300 sx; DST 3774-89 op 1 hr.
250' msw, BHP 1420#; DST 3626-60 op 1 hr.
rec. 105' wm, BHP 1300# 30"; DST 4428-40
op 2 hrs. rec. 270' gas, 90' gc and socm,
150' oil and gcm, BHP 680# 30"; DST 4440-55
op 2 hrs. rec. 100' mud,;
D & A

Co.
 Use.
 No.
 Sec.
 T.
 R.