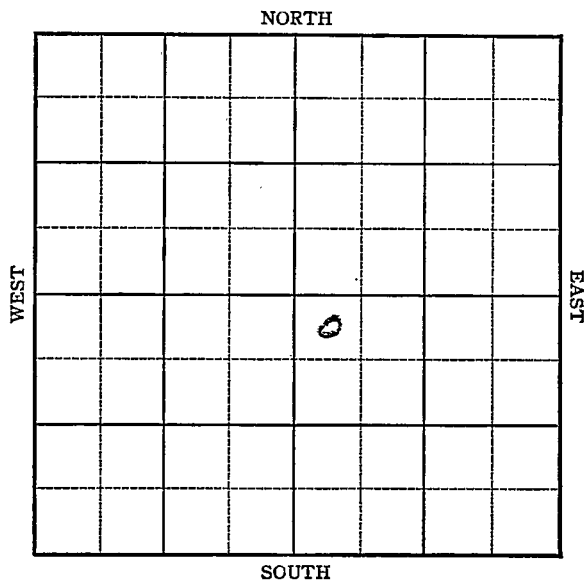


KANSAS

Section 19 Township 30 S Range 34 WWell No. #1 MurphyCompany KUHN BROS. ETAL

KANSAS

Haskell County

Sec. 19 Twp. 30 R. 34W

Well No. #1 Murphy Farm

Kuhn Bros. et al Company

Hugoton


100 Ft. from N. Line

Ft. from S. Line

Ft. from E. Line

100 Ft. from W. Line

NW SE *Chap. 2885*

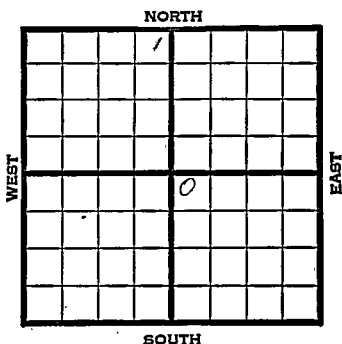

1945

REPORT

4/11	RUR
4/20	"
4/27	10" @ 500'
	Drlg. 1200'
5/3	7" @ 2511
	TD 2512' RUST
5/10	" " "
5/17	TD 2667
	5 M Gas.
	160' of 5" Perf. liner @ 2667 WOC
5/24	" " " " " " " "
5/31	" " " " " " " "
6/8	3000 acid
6/14	" " " " " " " "
6/21	" " " " " " " "
6/28	" " " " " " " "
7/11	7" @ 2511
	160' Perf. Liner @ 2667
	1200 acid.
	TD 2667
	16,692,000 Gas
	427# R Pr.

COMPLETED

Pool Name Hugoton

Kansas

Map No. No Map Sec. 19 Twp. 30 R. 34WWell No. 1 MurphyKuhn Bros etal


Company

FIRST REPORT

Contractor

NW SE

SECTION PLAT

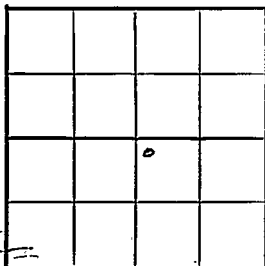100 Ft. from N. Line Ft. from S. Line Ft. from E. Line100 Ft. from W. LineHaskellLocation Rig up

Drilling and Remarks:

RUR

RECORD

Cased in., ft.Sand Gas Oil Total Depth

PRODUCTION

1st 24 hrs. Nat. 1st 24 hrs. after shot Gas Cu. Ft.Dry Hole Abandoned

Date

APR 11 194519S. J. LEWIS


Scout

KANSAS Kansas Pool Name HugotonMap No. no m 97 Sec. 19 Twp. 30 R. 34WWell No. 1 MurphyKuhn Bros et al Company**COMPLETED**

Contractor

NW SE

SECTION PLAT

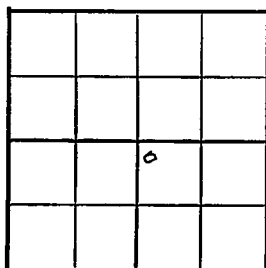100 Ft. from N. Line Ft. from S. Line Ft. from E. Line100 Ft. from W. LineHaskell CountyLocation Rig up

Drilling and Remarks:

7" C2511
 160' Perf liner @ 2667
 12000 acid
 16,692,000 Gas
 427# RPe

RECORD

Cased in., ft.Sand Gas Oil Total Depth 2667

PRODUCTION

1st 24 hrs. Nat. 1st 24 hrs. after shot Gas Cu. Ft.Dry Hole Abandoned

Date

JUL 1 1 1945 19S. J. LEWIS

Scout