
FORM 51 25M 3-49 PETROL Haskell

KANSAS

Section 19 Township 30 Range 32W

Well No. #1 Hoffman

Company Kansas Natural

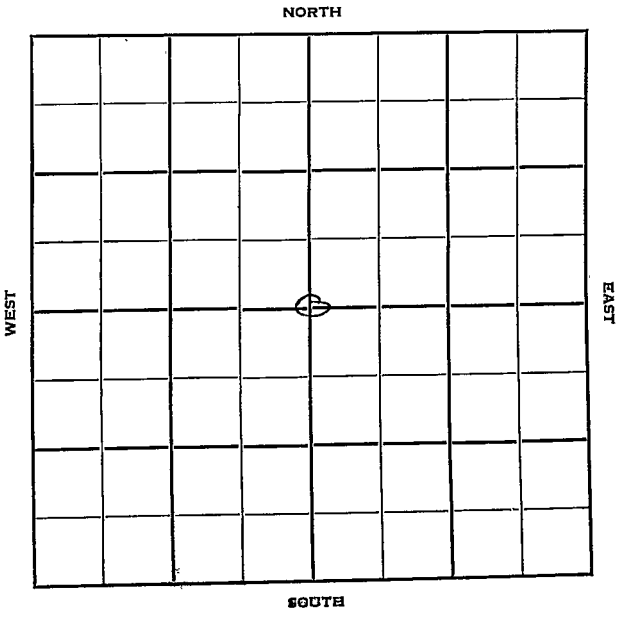

FORM 252-B Haskell

KANSAS ✓

Sec. 19 Twp. 30 R. 32W

Well No. #1 Hoffman Farm

Kansas Natural Company

Contractor


2640 Ft. from N. Line

Ft. from S. Line

2640 Ft. from E. Line

Ft. from W. Line

C of Sec.

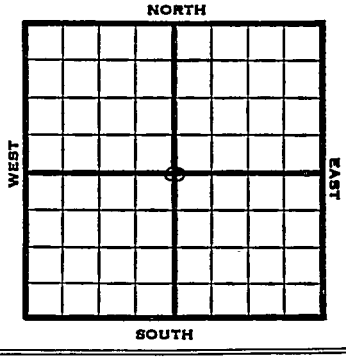

1952	Elev. 2909' REPORT
11/12	Location 10" @ 590'
11/20	Her 2627' Krider 2667 Winfield 2713 RTD 2713' Sch 7" @ ? DD 2720' TD 1000 A Fish swab.
11/27	NR
12/4	"
12/11	72/2636-48 120/2670-90 27,000A
12/17	Spud 11-3-52 Gas Well TD 2720 10" @ 590 Her 2627, Kri 2660, Win 2713 TD 2713 7" @ 2713 DD 2720 1000A 72/2636-48 120/2670-90 27000A Comp. 10,666,000 gas

COMPLETED

FORM 275 FOR SALE BY KANSAS BLUE PRINT CO.


County Haskell State Kansas

Sec. 19 (Blk. Twp.) 30 (Sur. Rge.) 32W Map No.

Operator Kansas Natural

Well No. 1 Farm Hoffman

Elev. Location C of Sec.

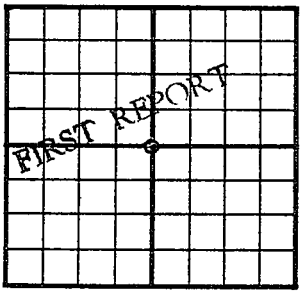

2640 Ft. From N Line Sec.

2640 Ft. From E Line Quarter

1st. Report NOV 12 1952

Completion

Remarks

Spudding Date

Drlg. Data

Location

J. G. McGEHEE

FORM 275 FOR SALE BY KANSAS BLUE PRINT CO


County Haskell State Kansas

Sec. 19 (Blk. Twp.) 30 (Sur. Rge.) 32W Map No.

Operator Kansas Natural

Well No. 1 Farm Hoffman

Elev. 2909 Location C SEc.

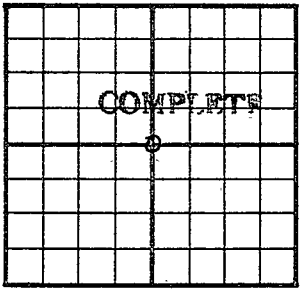

2640 Ft. From N Line Sec.

2640 Ft. From E Line Quarter

1st. Report

Completion DEC 17 1952

Remarks

Spudding Date 11-3-52

Drlg. Data Gas weld TD 2720

10" @ 590 Her. 2627 Kri. 2660

Win. 2713 TD 2713 7" @ 2713 DD 2720

1000 A 72/ 2636-48 120/ 2670-90

27000 A Comp. 10,666,000 gas

J. G. McGEHEE