

Kingman

KANSAS

19

30S

6W


SECTION _____ TOWNSHIP _____ RANGE _____

#1 Kalivoda

WELL NO. _____

Rupp-Ferguson

COMPANY _____

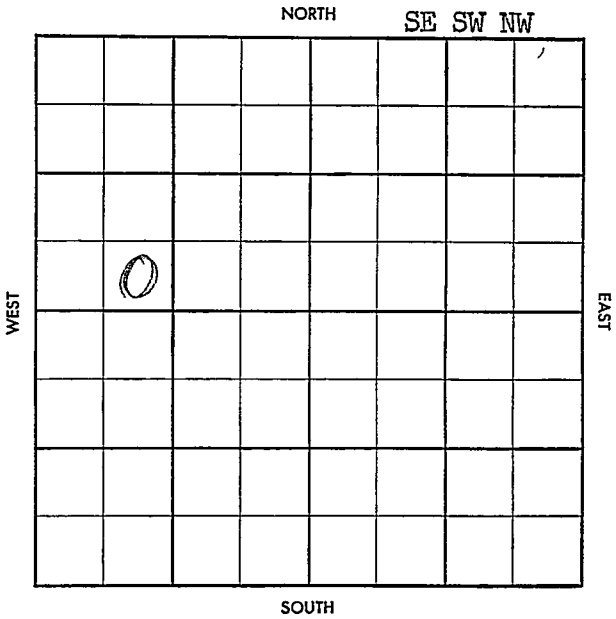

CO. Kingman ELEV. _____
 SEC. 19 TWP. 30S RGE. 6W
 COMPANY Rupp-Ferguson NO. 1

NOV 6 57
 0
 FIRST REPORT

FARM Kalivoda

LOC. SE SW NW

GEOL. _____

CONTR. Rupp Ferguson

POOL Reida SW

SPUD 11-1-57

8" 225 w/150; D 2419

LSE.

NO.

SEC.

TWP.

RGE.

S-513.A

CO. Kingman ELEV. 14670'

NOV 20 57

SEC. 19 TWP. 30S RGE. 6WCOMPANY Rupp-Ferguson NO. 1

ABANDONED

FARM KalivodaLOC. SE SW NW

GEOL. _____

CONTR Rupp FergusonPOOL Reida SWSPUD 11-1-578" 225 w/150; D 2419H63091Lsg 3328 KC3614 M 4155DST 4151 - 65 60"55' VSGCM FP0 BHP 1300 - 60 DST 4164 -72 60" 75' 506 G & WCMFP 0-0 BHP 1600 - 1600RTD 4250 Ann log

NOV 20 57

D&A