

Kingman

KANSAS

SECTION 19 TOWNSHIP 30 RANGE 7 W

WELL NO. #1 Aldrich "A"

COMPANY Purcell & Mull

NORTH

WEST

EAST

		0					

SOUTH

Kingman

KANSAS

SEC.	TWP.	R.
19	30	7W

WELL NO.

#4 Aldrich "A"

FARM

COMPANY

Purcell & Mull

CONTRACTOR

Pickrell

Spivey


_____ Ft. from N. Line

_____ Ft. from S. Line

_____ Ft. from E. Line

_____ Ft. from W. Line

SW N E NW

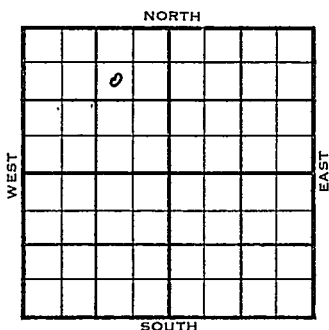

	ELEVATION	REPORT
1955	1537	
11/2	Comm 10-28-55 8" @ 120/125 Drlg 1130	
11-10	P & F/ 40 boph 2 hr.	
12-7	DST 4224-55 op 2 hrs. rec. 110' socm 300' ho&gcm, 110' clean oil 10' mo, 815/20" DST 4266-80 op 1 hr. 55 min. gas to surface in 4 min., 240 mcfg in 5 min. F/ oil in 1 hr., 28 min., 7 boph, 1575/30" 5 $\frac{1}{2}$ " @ 4342/150 CO 60/ 4264-74 S/ 5 boph, 750 A S/ 10 $\frac{1}{2}$ boph, 16 hrs. Comp. 333 bopd M. 4219 TD 4342'	4219 1537 ----- 2682

COMPLETED

County Kingman Elev. _____
 Sec. 19 Twp. 30 Rge. 7W
 Company Purgell & Mull
 Farm Name Aldrich "A" No. 4

TOPS	DEPTH	LOG	DATUM	Loc. in Sec.
Anh.				SW NE NW
Ip.				
H.				
Tr.				
Dg.				
BL.				
L.				Geol.
K.C.				Contr.
B.K.C.				<u>Pickrell</u>
Ce.				Pool
C.				<u>Spivey</u>
M.				
M.				
K.				
Mz.				
Mo.				
V.				
S.				
S.				
A				
R.				
Pe.				
G.				
T.D.				


Date Comm. 10-28-55
8" @ 120/125 drlg. 1430

FIRST REPORT
 NOV 2 '55

28

County Kingman Elev. 1537
 Sec. 19 Twp. 30 Rge. 7W
 Company Purcell & Mull
 Farm Name Aldrich "A" No. 4

TOPS	DEPTH	LOG	DATUM
Anh.			
Tp.			
H.			
Tr.			
Dg.			
BL.			
L.			
K.C.			
B.K.C.			
Ce.			
C.			
M.	<u>4219</u>		<u>2682</u>
M.			
K.			
Mz.			
Me.			
V.			
S.			
S.			
A.			
R.			
PE.			
G.			
TD.	<u>4342</u>		

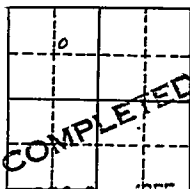Loc. in Sec. SW NE NWGeol. PickrellContr. SpiveyPool Spivey

DEC 7 1955

Date Comm. 10-28-55

8" @ 120/125 DST 1224-55 open 2 hr.
 rec. 110' socm 300' ho & gcm 110' clean
 oil 10' mo 815/20" DST 1266-80
 open 1 hr. 55 min. gas to surface in
 4 min. 240 mcfg in 5 min. F/ oil in
 1 hr. 28 min. 7 boph 1575/30"
 5 1/2" @ 1312/150 CO 60/1264-74
 S/ 5 boph 750 A S/ 10 1/2 boph 16 hr.
 Comp. 333 bopd