
DX 78-1

Kingman KANSAS

Section 19 Township 30 Range 7 W

Well No. # 1 Aldrich "A"

Company Petroleum Management

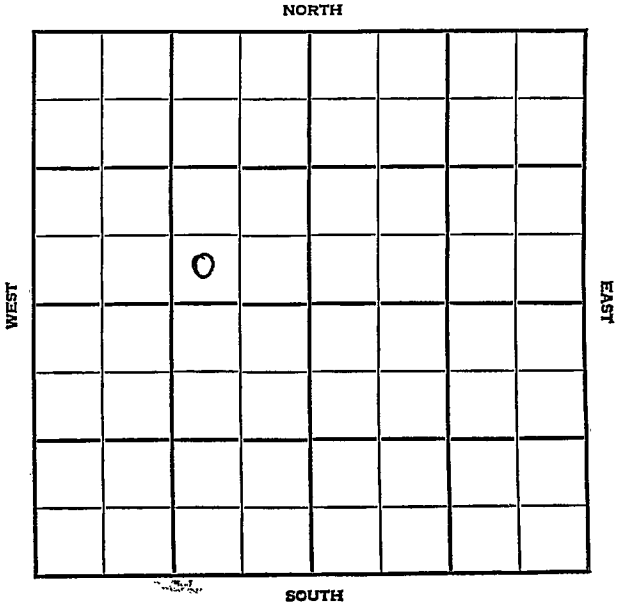

Kingman KANSAS

SEC.	TWP.	R.
19	30	7W

WELL NO.

1 Aldrich "A" FARM


COMPANY

Petroleum Management

CONTRACTOR

Pickrell Drlg.

Spivey Pool

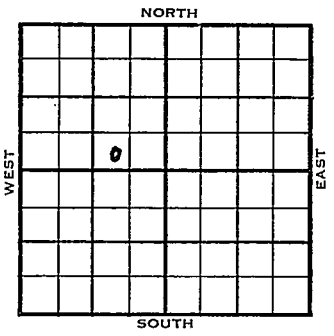

_____ Ft. from N. Line

330 Ft. from S. Line

990 Ft. from E. Line

_____ Ft. from W. Line

SW SE NW

1955	ELEVATION 1550'	REPORT
2/16		Spud 2-8-55 8" @ 171' Drlg. 3445'
4/13		Spud 2-8-55 Oil well TD 4380 8" @ 171 Lans 3416 Miss 4232 DST 4240-65 open 1 hr rec 90' SO & GCM, 120' O & GCM, 60' HO & GCM 800# DST 4270-95 open 1 hr rec 90' O & GCM 60' HO & GCM, 150' MCO, 30' SW 1170#. DST 4295-4335 open 1 hr rec 30' GCM 180' MCO, 225' free oil, 15' wtr. 940# TD 4380 5" @ 4377 CO to 4370 60/4244-59 250 M-A sd-oil-ffac. F/5 BOPH 4 hr. Comp. F/186 BOPD 15% wtr. **COMPLETED**

DX-78

FORM 275 FOR SALE BY KANSAS BLUE PRINT CO.


County Kingman State Kansas

Sec. 19 (Blk. Twp.) 30 (Sur. Rge.) 7W Map No.

Operator Petroleum Management

Well No. 1 Farm Aldrich "A"

Elev. Location SW SE NW

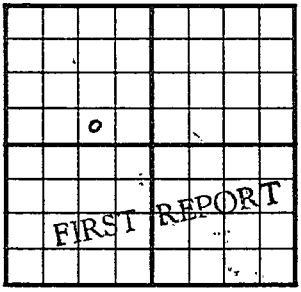

330 Ft. From S Line NW

990 Ft. From E Line Quarter

1st. Report FEB 16 1955

Completion

Remarks Pickrell Drlg. - Contr.

Spudding Date 2-8-55

Drlg. Data Spivey Pool

8" @ 171 drlg. 3445

FABEN GILSTRAP

FORM 275 FOR SALE BY KANSAS BLUE PRINT CO.


County Kingman State Kansas

Sec. 19 (Blk. Twp.) 30 (Sur. Rge.) 7W Map No.

Operator Petroleum Management

Well No. 1 Farm Aldrich "A"

Elev. 1550 Location SW SE NW

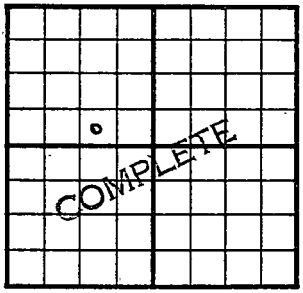

330 Ft. From S Line NW

990 Ft. From E Line Quarter

1st. Report

Completion APR 13 1955

Remarks Spivey Pool

Pickrell Drlg. - Contr.

Spudding Date 2-8-55

Drlg. Data Oil well TD 4380

8" @ 171 Lans. 3416 Miss. 4232

DST 4240-65 open 1 hr. Rec. 90' so & gcm 120' o & gcm 60' ho & gcm 800#

DST 4270-95 open 1 hr. Rec. 90' o & gcm 60' ho & gcm 150' mco 30' sw 1170#

DST 4295-4335 open 1 hr. Rec. 30' gcm 180' mco 225' free oil 15' wtr. 940# TD 4380 5" @ 4377 CO to 4370

60/ 4244-59 250 M-A sd-oil-frac F/ 5 boph 4 hr. Comp. F/ 186 bopd 15% w

FABEN GILSTRAP