
Kingman KANSAS

DX 78-1

Section 19 Township 30 Range 7W

Well No. 1 Tjaden "B"

Company Pickrell Drlg.

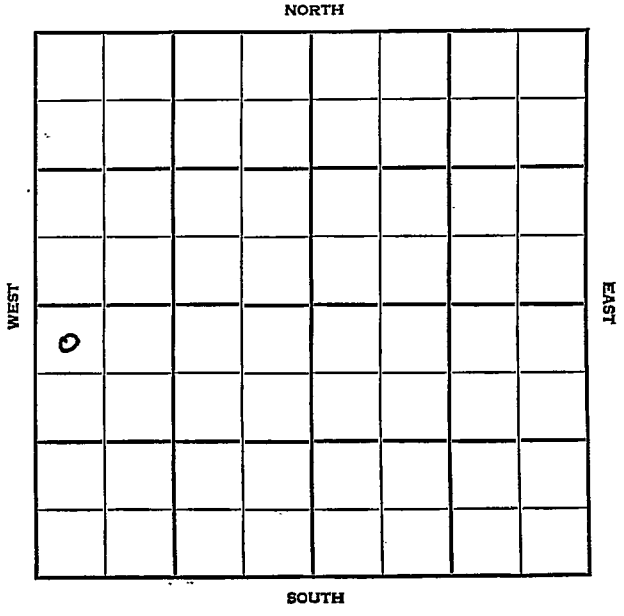

Kingman		KANSAS
SEC.	TWP.	R.
19	30	7W

WELL NO.

1 Tjaden "B" FARM

COMPANY

Pickrell Drlg.

CONTRACTOR


Pickrell

330 Ft. from N. Line

Ft. from S. Line

Ft. from E. Line

330 Ft. from W. Line

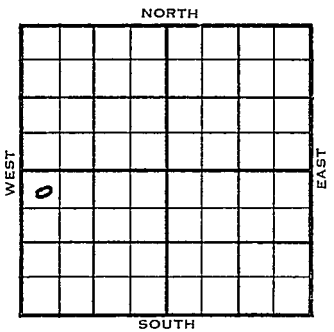

NW NW SW

1954	ELEVATION 1516	REPORT
6/15	M I R	
6/23	8" @ 160 Drlg. 3110'	
8-18	Spdg 6-16-54 Oil well TD 4333 8" @ 160 Lans. 3380 Miss. 4194 DST 4202-20 open 1 hr. Rec. 180' o & gcm 760# DST 4220-50 open 1 hr. Rec. 900' o & gcm 120' ho & gcm 100' mud & gco 20' wtr. 900# DST 4250-80 open 1 hr. Rec. 90' o & gcm 300' mud 1000# TD 4333 5" @ 4332 CO to 4300 120/ 4210-40 frac F/ 17 boph 8 hr. F/ 139 bf 8 hr. 20% wtr. F/ 139 bf 8 hr. 15 to 20% wtr. Comp. 205 bopd 37% wtr.	

COMPLETED

DX-78

FORM 275 FOR SALE BY KANSAS BLUE PRINT CO.


County Kingman State Kansas

Sec. 19 (Blk. Twp.) 30 (Sur. Rge.) 7W Map No.

Operator Pickrell Drlg.

Well No. 1 Farm Tjaden "B"

Elev. Location NW NW SW

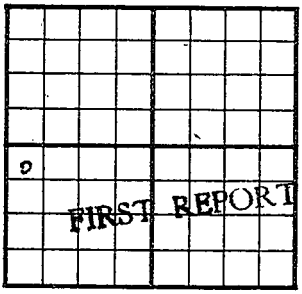

330 Ft. From N Line SW

330 Ft. From W Line Quarter

1st. Report JUN 15 1954

Completion

Remarks Pickrell - Contr.

Spudding Date

Drlg. Data

M I R

J. G. McGEHEE

FORM 275 FOR SALE BY KANSAS BLUE PRINT CO.


County Kingman State Kansas

Sec. 19 (Blk. Twp.) 30 (Sur. Rge.) 7W Map No.

Operator Pickrell Drlg.

Well No. 1 Farm Tjaden "B"

Elev. 1516 Location NW NW SW

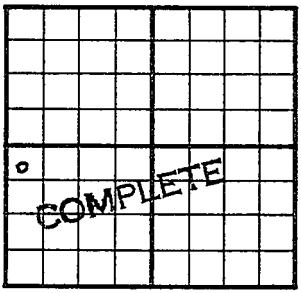

330 Ft. From N Line SW

330 Ft. From W Line Quarter

1st. Report

Completion AUG 1 8 1954

Remarks

Pickrell - Contr.

Spudding Date 6-16-54

Drlg. Data Oil well TD 4333

8" @ 160 Lans. 3380 Miss. 4194

DST 4202-20 open 1 hr. Rec. 180' o & gcm 760# DST 4220-50 open 1 hr. Rec. 90' o & gcm 120' ho & gcm 100' mud & gco 20' wtr. 900# DST 4250-80 open 1 hr. Rec. 90' o & gcm 300' mud 1000# TD 4333 5" @ 4332 CO to 4300 120/ 4210-40 frac F/ 17 boph 8 hr. F/ 139 bf 8 hr. 20% wtr. F/ 139 bf 8 hr. 15 to 20% wtr.

Comp. 205 bopd 37% wtr.

FABEN GILSTRAP