FORM 51 25M 3-49 PETROL


KANSAS Grant

Section 19 Township 30 Range 38-W

Well No. #1 W Davis "B"

Company Stanolind

Hugoton Pool

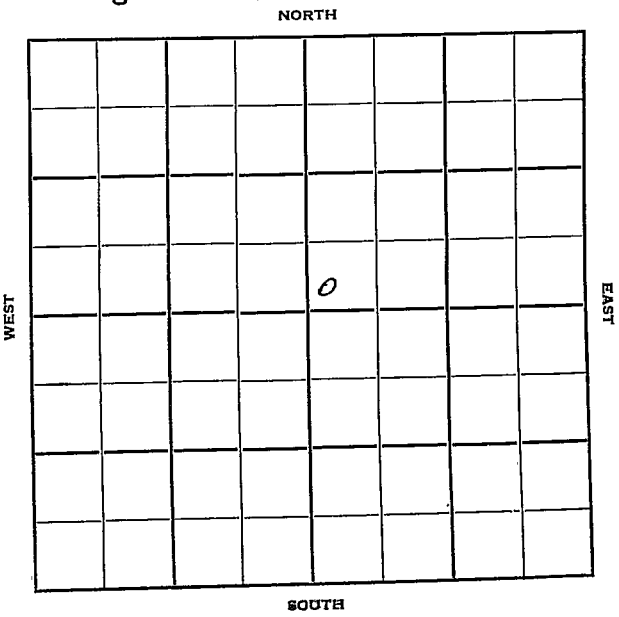

FORM 252-B
10M 9-49 PETROL

Grant KANSAS

Sec. 19 Twp. 30 R. 38W

Well No. #1 W. Davis "B" Farm

Stanolind Company

Contractor

Hugoton Pool


Ft. from N. Line

150' Ft. from S. Line

Ft. from E. Line

150' Ft. from W. Line

SW NE

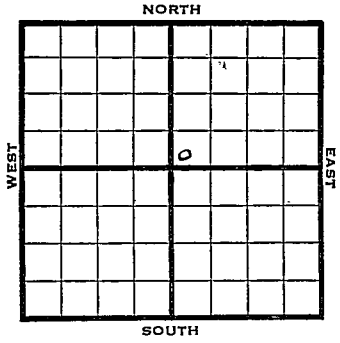

1949	Elev 3161' REPORT
10/26	Location
11/1	"
11/9	"
11/16	"
11/23	10" @ 575'
11/29	"
12/7	Drlg 2440'
12/14	TD 2648' 7" @ 2428'
12/21	TD 2612' 7"@ 2577' Perf 33500' acid 12,237,000 Gas 405# R Pr. Comp

COMPLETED

Form 26 200 Bks. 6-49 Petrol

Kansas

Hugoton Pool

Map No. _____ Sec. 19 Twp. 30 R. 38W

Well No. 1 W. Davis "B"


Stanolind Company

Contractor

SW NE

FIRST REPORT

SECTION PLAT

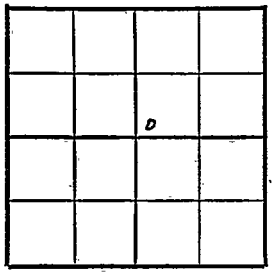

_____ Ft. from N. Line

150 Ft. from S. Line

_____ Ft. from E. Line

150 Ft. from W. Line

Grant County

Location X

Rig up

Drilling and Remarks:

RECORD

Cased _____ in., _____ ft.

Sand

Gas

Oil

Total Depth

PRODUCTION.

1st 24 hrs. Nat.

1st 24 hrs. after shot.

Gas _____ Cu. Ft.

Dry Hole

Abandoned

Date

OCT 26 1949 19

S. J. LEWIS Scout