FORM 51 25M 3-49 PETROL

KANSAS


Grant

Section 19 Township 30 Range 38-W

Well No. #1 W Davis "B"

Company Stanolind

Hugoton Pool

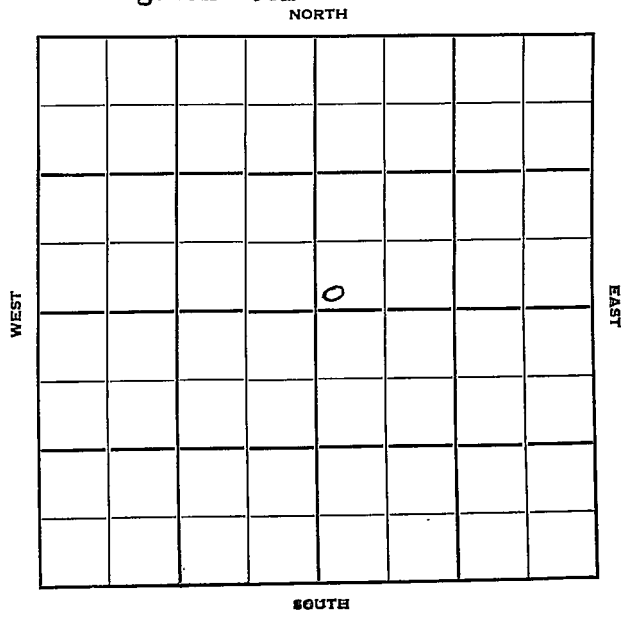

FORM 252-B
10M 9-49 PETROL

KANSAS
Duplicate

Grant

Sec. 19 Twp. 30 R. 38W

Well No. #1 W. Davis "B" Farm

Stanolind Company

Contractor


Ft. from N. Line

150' Ft. from S. Line

Ft. from E. Line

150' Ft. from W. Line

SW NE

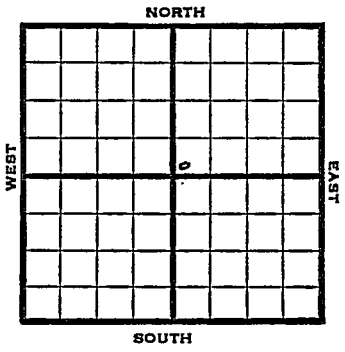

1950	Elev. 3150' REPORT
3/1	10" @ 610' 7" @ 2428' 12,237,000 CFGPD TD 2648' COMPLETED

Form 26 200 Bks. 11-49 Petrol

Hugoton Pool

Kansas

Map No. ____ Sec. 19 Twp. 30 R. 38W

Well No. 1 W. Davis "B"


Stanolind Company

Contractor

SW NE

El 3150

SECTION PLAT

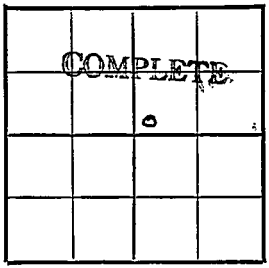

____ Ft. from N. Line

150 Ft. from S. Line

____ Ft. from E. Line

150 Ft. from W. Line

Grant County

Location ____

Rig up ____

Drilling and Remarks:

10" @ 610

7" @ 2428

12,237,000

C.F.G.P.D

RECORD

Cased ____ in., ____ ft.

Sand ____

Gas ____

Oil ____

Total Depth 2648

PRODUCTION

1st 24 hrs. Nat. ____

1st 24 hrs. after shot ____

Gas ____ Cu. Ft.

Dry Hole ____

Abandoned ____

Date

MAR 1 1950

19

J. E. TYRA Scout