


Stanton

KANSAS

SECTION 19 TOWNSHIP 30 RANGE 42W

WELL NO. #1 Hume

COMPANY Superior

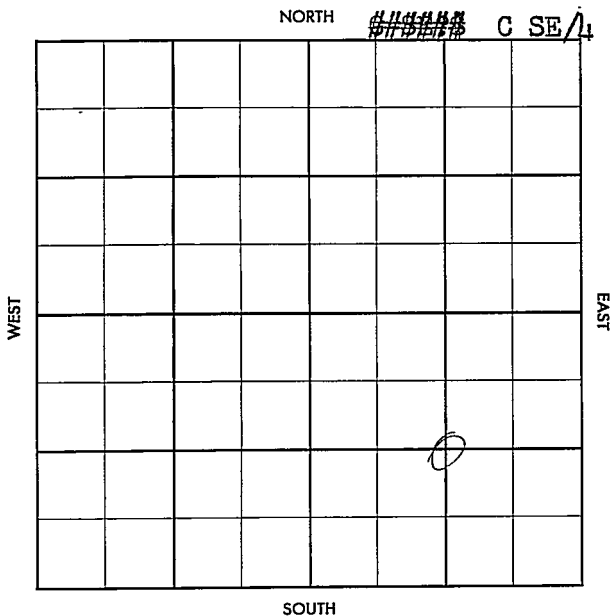

WILDCAT

County Stanton Elev. _____
 Sec. 19 Twp. 30 Rgs. 1, 2W
 Company Superior
 FarmName Hume No. 1

TOPS	DEPTH	LOG	DATUM	Loc. in Sec.
Anh.				C SE/4
Tp.				
H.				
Tr.				
Dg.				
BL.				
L.				Geol. _____
K.C.				Contr. _____
B.K.C.				
Ce.				
C.				
M.				
M.				Pool
K.				Wildcat
Mz.				<div style="border: 1px dashed black; padding: 5px; display: inline-block;"> <p style="font-size: 2em; margin: 0;">FIRST REPORT</p> <p style="margin: 0;">JAN 30 '37</p> </div>
Me.				
V.				
S.				
S.				
A.				
R.				
PE.				
G.				
T.D.				

Date Comm. _____

Location _____

~~34~~

Co. Sec. T. R.

34

County Stanton Elev. 3581
 Sec. 19 Twp. 30 Rge. 12W
 Company Superior
 FarmName Hume No. 1-19

TOPS	'DEPTH	LOG	DATUM	Loc. in Sec.
Anh. <u>W26</u>		<u>2888</u>		C SE/4
Tp. <u>E177</u>		<u>3198</u>		
H. <u>TY</u>		<u>3357</u>		
Tr. <u>Le cp</u>		<u>3513</u>		
Dg. <u>Hh</u>		<u>3628</u>		
Bl. <u></u>		<u>3683</u>		
L. <u>Harm</u>		<u>4267</u>		
K.C. <u>Mush</u>		<u>5022</u>		Geol. <u></u>
BKC. <u>" sd</u>		<u>5302</u>		Cont. <u>COX</u>
Ce. <u></u>				<p>ABANDONED</p> <p>SPARS Pool Wildcat</p>
C. <u>chest</u>		<u>5442</u>		
M. <u></u>				
M. <u></u>				
K. <u></u>				
Mz. <u></u>				
Ma. <u></u>				
V. <u></u>				
S. <u></u>				
A. <u></u>				
R. <u></u>				
PE. <u></u>				
G. <u></u>				
TR. <u></u>	<u>5477</u>			FEB 27 '57

Date Comm.
 Location EB 6 57 2-1-57 D 1550
FEB 13 '57 10 3/4 @ 1518 / 800 D 3558
17 D 4950 - DST 5389
- 5449 1 hr 180' Md + 2820' SW
FP 460-1310 2314 1310/30"
D & L