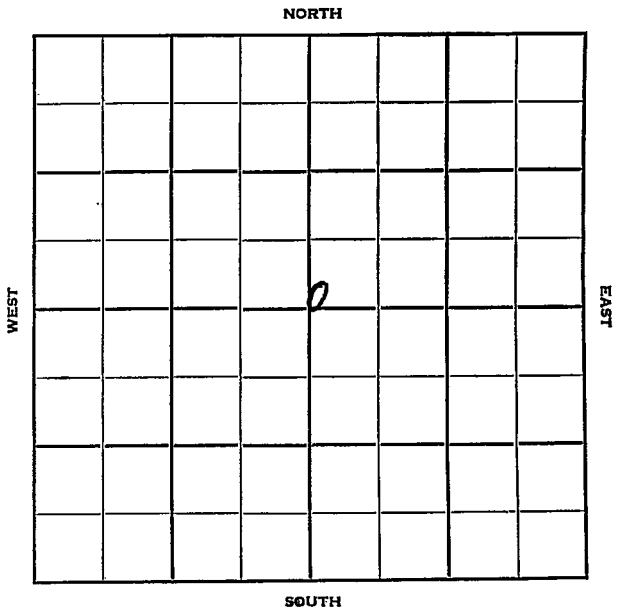


Section 19 Township 30 Range 31 WWell No. # 2 HammerCompany Helmerich & Payne

Haskell

KANSAS ✓

Sec. 19 Twp. 30 R. 31 WWell No. # 2 Hammer FarmHelmerich & Payne Company

Contractor

Hugoton Pool


Ft. from N. Line

150 Ft. from S. Line

Ft. from E. Line

150 Ft. from W. Line

SW NE

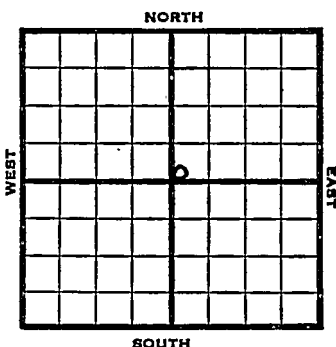

1953

Elev. 2852'

REPORT

6/24

Location

7/1

"

7/8

"

7/15

"

7/22

"

7/29

"

8/26

"


9/2

Abd. Location

ABANDONED

J. G. McGEHEE

County Haskell State Kansas
 Sec. 19 (Blk. 30 (Sur. 31W Map No.
 (Twp.) (Rge.)
 Operator Helmerich & Payne
 Well No. 2 Farm Hammer
 Elev. 2852 Location SW NE

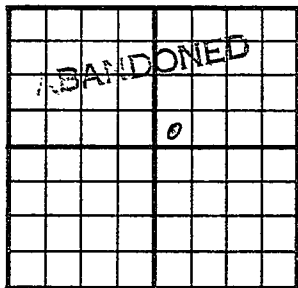

150 Ft. From S Line NE
150 Ft. From W Line Quarter
 1st. Report
 Completion SEP 2 1953
 Remarks Hugoton Pool
 Spudding Date

Drilg. Data

Abd. location