


Section 2 Township 30 Range 11W

Well No. 1 Kiras

Company Ashton Oil

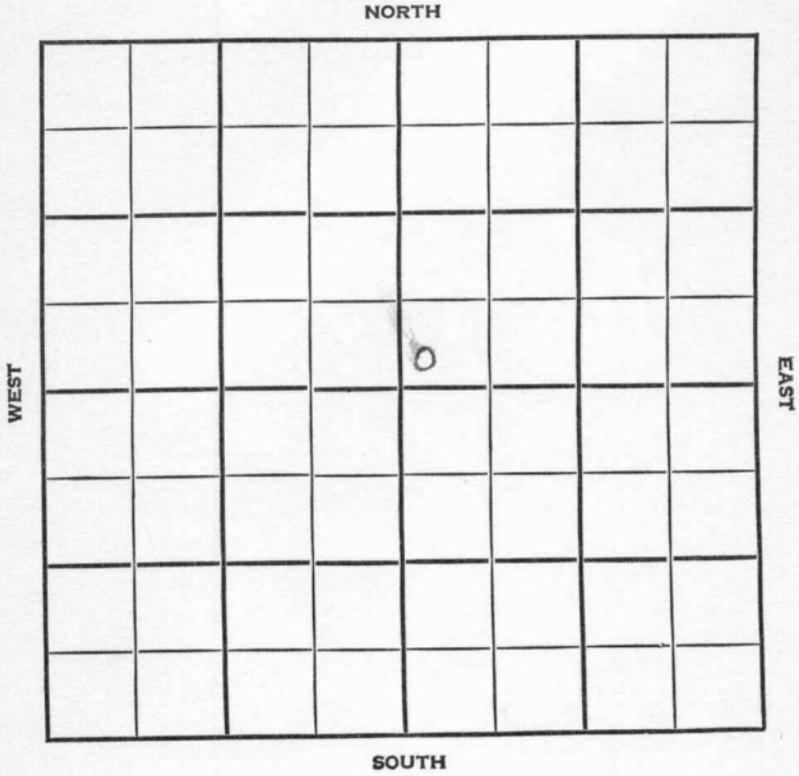

SEC.

HOT FILE

TWP.

2

30S

R.

14W

WELL NO.

#1 Kiras

FARM

COMPANY

Ashton Oil

CONTRACTOR


Wildcat

_____ Ft. from N. Line

_____ Ft. from S. Line

_____ Ft. from E. Line

_____ Ft. from W. Line

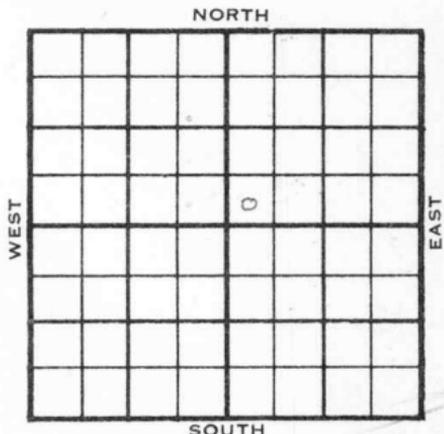

N SW SW NE

(5/8 mile Sunray)

	ELEVATION	REPORT
1955	1931'	
5/26		Log tops: Heeb 3748, Br Lime 3942, Lans 3952, Cong 4418, Simp 4441, Arb 4534, Cored 4471-89 rec? DST 4530-40 open 1 hr, rec 30' mud, BHP 1550/20" Arb 4538, DST 4540-55 open 1½ hr, rec 475' sul wtr. FP 0-240#, BHP 1560/20" DST 4370-91 open 1 hr, gas in 9 min, gauge 1,240 Mcfg in 40 min, Rec 60' oil plus 240' smo plus 660' mgo & oily mud, BHP 1375#, rng DST 4383-90 5½" @ 4555' MICT
6/2		
6/9		Perf/4381-89, no shows. Re-perf 3 MCFG
6/16		1000 A Gauge 4,300 MCFG
6/23		No report
6/30		No report
7/7		Waiting on connection
7/14		4,500 mcfpd
7/20		Comm: 5-1-55 DST 4098-4110 open 1 hr Rec. 2008 wgcM 960' SW 1450/20" DST 4530-40 open 1 hr. Rec. 30' mud 1550/20" DS 4540 55, open 1½ hr. Rec. 475' sul wtr. 1560/20" DST 4370-91 open 1 hr. gas in

9 min 1,240 mcgg in 40 min. Rec. 60
oil 240' smo 660' mud, 1375# 5 1/2"
@4555, perf 4381-89 no show reperf
3 mcfg 1000 A 4,300 mcfg Comp. 4,500
mcfgpd

Tops	Depth	Log	Datum
H.	3763	3748	1917
B1	3931	3942	2011
L.	3946	3952	2021
KC Marm		4298	2367
BKC	4300		2369
<i>Cong</i>		4418	2487
<i>Simp</i>	4445	4441	2510
A r	4538	4534	2603
TD	4555		

COMPLETED

County Barber Elev. 1931
 Sec. 2 Twp. 30 Rgs. 14W
 Company Ashton Oil
 Farm Name Kiras No. 1

TOPS	DEPTH	LOG	DATUM
Anh.			
Tp.			
H.	3763	3748	1817
Tr.			
Dg.			
Bl.	3931	3942	2011
L.	3946	3952	2021
K.C.	2280	4298	2367
B.K.C.	4300		2367
Ce.			
C.		4418	2487
M.			
M.			
K.			
Mz.			
Me.			
V.			
S.	4445	4441	2510
S.			
A	4538	4534	2603
R.			
Pe.			
G.			
T.D.	4533		

Loc. in Sec. SW SW NE
 Geol. _____
 Contr. _____
 Pool Wildcat

COMPLETE

Date Comm. 5-1-55 JUL 20 1955
 DST 4098-4110 open 1 hr. Rec. 200'
 wgcw 960' sw 1450/20" DST 4550-
 40 open 1 hr. Rec. 30' mud 1550/20"
 DST 4540-55 open 1½ hr. Rec. 475'
 sul. wtr. 1560/20" DST 4370-91
 open 1 hr. gas in 9 min. 1,240 mcfg
 in 40 min. Rec. 60' oil 240' smo
 660' mud, 1375# 5½" @ 4555

OVER

JUL 27 1953

Scout Cards	JC
Land Small Map	
Land Wall Map	
Tracings	
France Map	
Pierce Map	
Misc.	

part. 4381-89 no show report.
3 mfg 1000 A 4,360 mfg
Comp. 4,500 mfgpd