
FORM 51 25M 3-49 PETROL Barber KANSAS

Section 2 Township 30 Range 14W

Well No. #2 Kiras

Company Rine & Roberts & Murphy

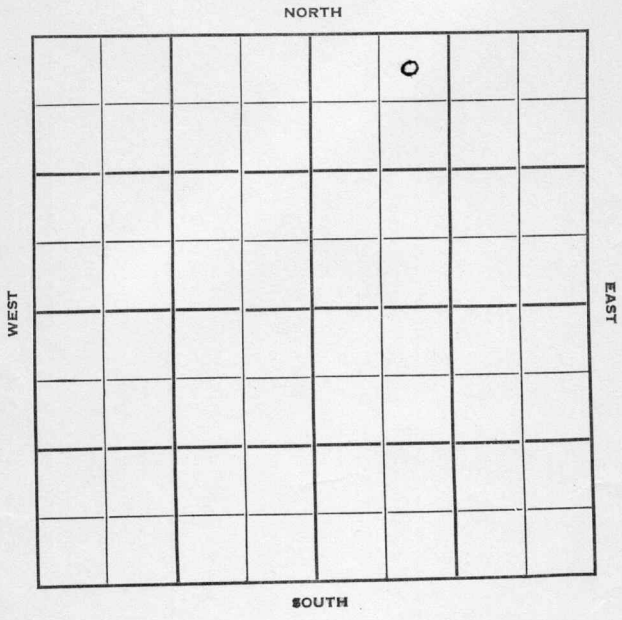

FORM 252-B
10M 9-49 PETROL

KANSAS Barber

Sec. 2 Twp. 30 R. 14-W

Well No. #2 Kiras Farm

Rine & Roberts & Murphy Company

Contractor

Clara Pool


330 Ft. from N. Line

Ft. from S. Line

Ft. from E. Line

990 Ft. from W. Line

NE NW NE

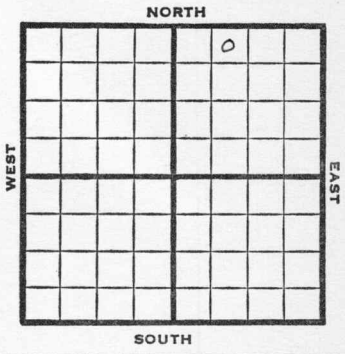

1950	Elev 1949	REPORT
7/26	Spud 7-20-50	
	8 5/8" @ 370	
	drlg 2985	
8/16	8 5/8" @ 370	
	Heeb 3726	Doug 3793
	Br lime 3923	Lans 3936
	B KC 4310	Cong 4334
	Viola 4410	Simp 4430
	Arb 4522-50 TD	
	TD 4550	
	D&A	
	ABANDONED	

Form 26 200 Bks. 11-49 Petrol

Kansas

Clara Pool

Map No. _____ Sec. 2 Twp. 30 R. 14W

Well No. 2 Kiras

Rine & Roberts & Murphy Company

Contractor

NE NW NE

330 Ft. from N. Line

Ft. from S. Line

Ft. from E. Line

990 Ft. from W. Line

SECTION PLAT



Barber County

Location

Rig up

Drilling and Remarks:

Spud 7-20-50

8 5/8" @ 370

drlg. 2985

RECORD

Cased in., ft.

Sand

Gas

Oil

Total Depth

PRODUCTION

1st 24 hrs. Nat.

1st 24 hrs. after shot

Gas Cu. Ft.

Dry Hole

Abandoned

Date

JUL 26 1950 19

J. E. TYRA Scout



AUG 2 1950

Scout Cards 7 W
Land Small Map
Land Wall Map 35
Tracings
France Map
Pierce Map
Misc.

FORM 275 FOR SALE BY KANSAS BLUE PRINT CO.

County Barber State Kansas

Sec. 2 (Blk. Twp.) 30 (Sur. Rge.) 14W Map No.

Operator Rine & Roberts & Murphy

Well No. 2 Farm Kiras

Elev. 1949 Location NE NW NE



330 Ft. From N Line NE

990 Ft. From W Line Quarter

1st. Report

Completion AUG 1 6 1950

Remarks

Spudding Date 7-20-50

Drlg. Data D & A TD 4550

8 5/8" @ 370 Heeb. 3726 Doug. 3793

Br. lime 3923 Lans. 3936 B KC 4310

Cong. 4334 Viola 4410 Simp. 4430

Arb. 4522-50 TD D & A

J. E. TYRA

Scout Cards 7 W
Land Small Map
Land Wall Map 3
Tracings
France Map
Pierce Map
Misc.

AUG 21 1950

Drlg. Data