
FORM 51 25M 3-49 PETROL KANSAS Barber

Section 2 Township 30 Range 14W

Well No. #2 Kiras

Company Rine Drlg. et al

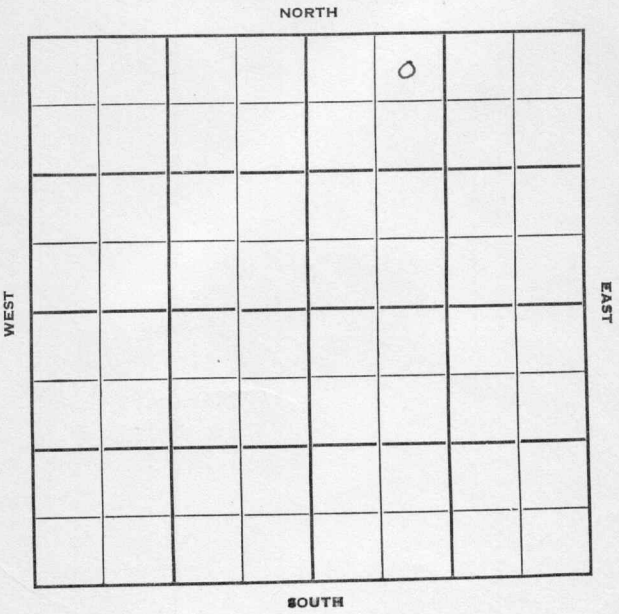

FORM 252-A
5M 10-48 PETROL

KANSAS Barber

Sec. 2 Twp. 30 R. 14-W

Well No. #2 Kiras Farm

Rine Drlg Etal Company

Cont Rine Drlg
Clara


330 Ft. from N. Line

Ft. from S. Line

Ft. from E. Line

990 Ft. from W. Line

NE NW NE

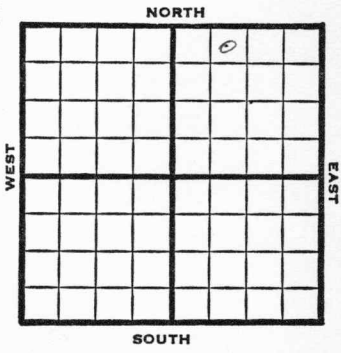

1949	REPORT
10/5	Location
10/12	"
10/19	"
10/26	Location ABANDONED

Form 26 200 Bks. 6-49 Petrol

Kansas

Clara Pool

Map No. ____ Sec. 2 Twp. 30 R. 14W

Well No. 2 Kiras


Rine Drlg. etal. Company

Rine Drlg. Contractor

NE NW NE

FIRST REPORT

SECTION PLAT

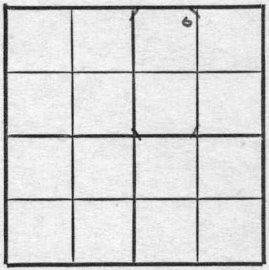

330 Ft. from N. Line

____ Ft. from S. Line

____ Ft. from E. Line

990 Ft. from W. Line

Barber County

Location x

Rig up

Drilling and Remarks:

RECORD

Cased ____ in., ____ ft.

Sand

Gas

Oil

Total Depth

PRODUCTION

1st 24 hrs. Nat.

1st 24 hrs. after shot

Gas ____ Cu. Ft.

Dry Hole

Abandoned

Date

OCT 5 1949

19 S. J. LEWIS Scout

Form 26 200 Bks. 6-49 Petrol

Kansas

Clara Pool

Map No. _____ Sec. 2 Twp. 30 R. 14W

Well No. 2 Kiras

Rine Drlg. etal. Company

ABANDONED Contractor

NE NW NE


330 Ft. from N. Line

_____ Ft. from S. Line

_____ Ft. from E. Line

990 Ft. from W. Line

SECTION PLAT

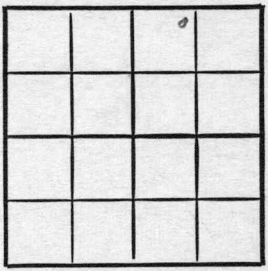

Barber County

Location ✓

Rig up _____

Drilling and Remarks:

RECORD

Cased _____ in., _____ ft.

Sand _____

Gas _____

Oil _____

Total Depth _____

PRODUCTION

1st 24 hrs. Nat. _____

1st 24 hrs. after shot _____

Gas _____ Cu. Ft.

Dry Hole _____

Abandoned _____

Date

OCT 26 1949 19

S. J. LEWIS Scout