


Map No. KANSAS Sec. 2 Twp. 30 R. 12^w

Well No. 1- Gumbury Farm
Allison - Fitz Williams Company

NORTH

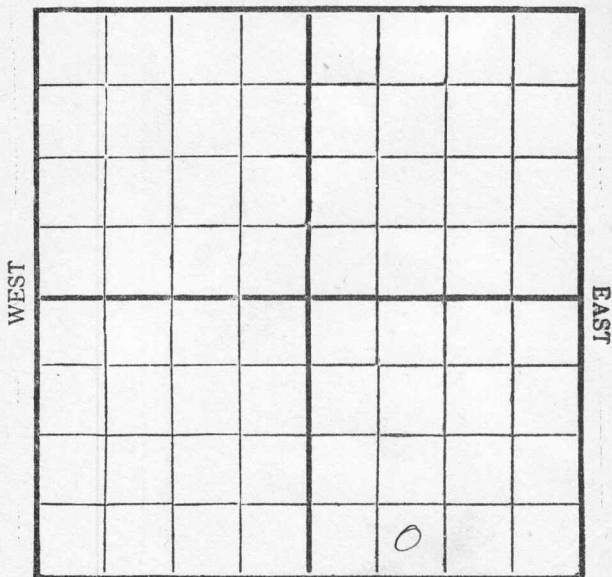

SOUTH

Location _____

Drilling Remarks _____

Rig Up _____

Drilling Remarks _____

RECORD

Cased _____ in. _____ ft.

Sand _____

Gas _____

Oil _____

Total Depth _____

PRODUCTION

1st 24 hrs. Nat. _____

1st 24 hrs. after shot _____

Gas _____ cu. ft. _____

Dry Hole _____


Abandoned _____

Map No. KANSAS Sec. 2 Twp. 30 R. 12^w

Well No. 1- Kumburg Farm

Allison - Fitzwilliams Company

NORTH

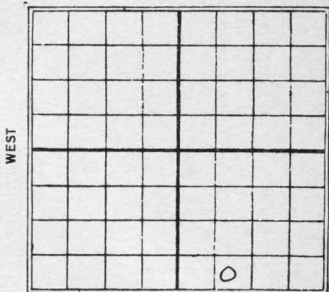

_____ Ft. from N. Line

330 Ft. from S. Line

_____ Ft. from E. Line

990 Ft. from W. Line

1930

SOUTH

Date	REPORT
3/12	Rig
3/19	Rigging up.
3/26	—
4/2	Spud
4/9	Spud 190'
4/16	Rdrg 1130'
4/23	" 1875'
	12" - 1140'
4/30	S.D. 2050'
5/7	—
5/14	—
5/21	—
5/28	—
6/4	—
6/11	—
6/18	Rdrg. 2070'
6/25	" 2375'
7/2	" 2475'
	10" - 2386'
7/9	Rdrg. 2490'
7/16	U.R. 10" - 2600'

7/23- Hrlg. 2647'

7/30 - " 2838'

10"- 2660'

8/6- Hrlg. 3210'

8/13- H72W. 3240' S.D.

8/20- U/R 8"- 3270'

8/27- Hrlg. 3400'

9/3- U.R. 8"- 3415'

9/10- U/R 8"- 3510'

9/17- Cky out 3576'

9/24- T.D. 3576'

Pem 8"- 3546'

10/1- Hrlg. 3920'

10/8- Cement Cave 3925'

10/15- 6"- 3938'

Drly 3985'

10/22- HFW 3990'

Drly 4025'

10/29- " 4123'

11/5- " 4136'

S/R 8"- Pulled 6'

11/12- U/R 6"- 4259'

11/19- 6"- 4258'

Drly 4275'

11/26- 6"- 4324'

Hrlg. 4330'

12/3- show oil at 4370'

Top Chat 4390'

Base Miss 4434'

Drly 4500'

Map No. Km595 Sec. 2 Twp. 30 R. 12^w

Well No. 1- Kumburg Farm
Allison-Fitzwilliams Company

NORTH


_____ Ft. from N. Line

330 Ft. from S. Line

_____ Ft. from E. Line

940 Ft. from W. Line

1930

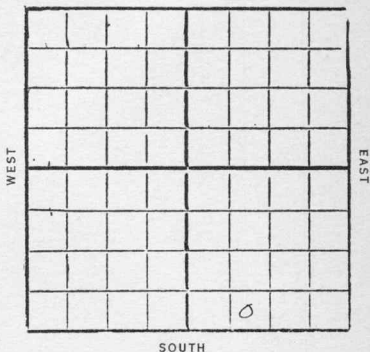

Date	REPORT
12/10	HFW 4679-80 UIR 8" csg
12/17	UIR 6"-4680'
12/23	6"-4680'
12/30	T.D. 4690' Clg out
1/31	
1/7	Dry 4733'
1/14	6"-4758'
1/21	dry 4763'
1/28	UIR 6"-4790'
2/4	SD 4801 repairs
2/11	
2/18	show oil 4790-93 HFW at 4799 T.D. 4825'
	Dry & Abandon

Map No. KANSAS Sec. 2 Twp. 30 R. 12 W

Well No. 1 Hamberg

Callison & Fitzwilliams Company

Contractor

SECTION PLAT

..... Ft. from N. Line

330 Ft. from S. Line

..... Ft. from E. Line

990 Ft. from W. Line

FIRST REPORTS

Location.....

Rig up.....

Drilling and Remarks:

Rig

RECORD

Cased..... in., ft.

Sand.....

Gas.....

Oil.....

Total Depth.....

PRODUCTION

1st 24 hrs. Nat.....

1st 24 hrs. after shot.....

Gas..... Cu. Ft.

Dry Hole.....


Abandoned.....

Date

MAR 12 1930

S. J. LEWIS Scout

Well No. _____
Map No. _____
Section _____
Company _____
Contractor _____

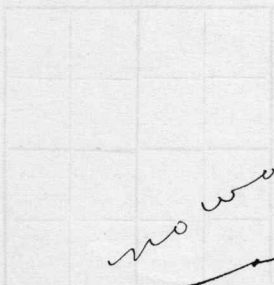

no water

Returned	<i>[Signature]</i>
Cards	<i>[Signature]</i>
Tracing	<i>[Signature]</i>
France Map	<i>[Signature]</i>
Scarborough Map	<i>X</i>
Moody Map	<i>[Signature]</i>
Scarborough Pit Book	<i>[Signature]</i>
Moody Pit Book	<i>[Signature]</i>

Date _____
Sheet _____

Barber
 Map No. **KANSAS** Sec. 2 Twp. 30 R. 12 N
 54
 Well No. 1 Turner

Ellison & F. Williams Company
 Contractor

SECTION PLAT

.....Ft. from N. Line

0380 Ft. from S. Line

.....Ft. from E. Line

990 Ft. from W. Line

ABANDONED

Location.....

Rig up.....

Drilling and Remarks:

Blow out 4790-93

NFW 4799

RECORD

Cased.....in.,ft.

Sand.....

Gas.....

Oil.....

Total Depth 4825

PRODUCTION

1st 24 hrs. Nat.....

1st 24 hrs. after shot.....

Gas.....Cu. Ft.

Dry Hole.....

Abandoned.....

Date

FEB 13 1931

S. J. LEWIS Scout

Handwritten signature and scribbles

Returned	
Cards	<i>Handwritten initials</i>
Tracing	<i>Handwritten initials</i>
France Map	X
Scarborough Map	X
Moody Map	X
Scarborough Plat Book	
Moody Plat Book	