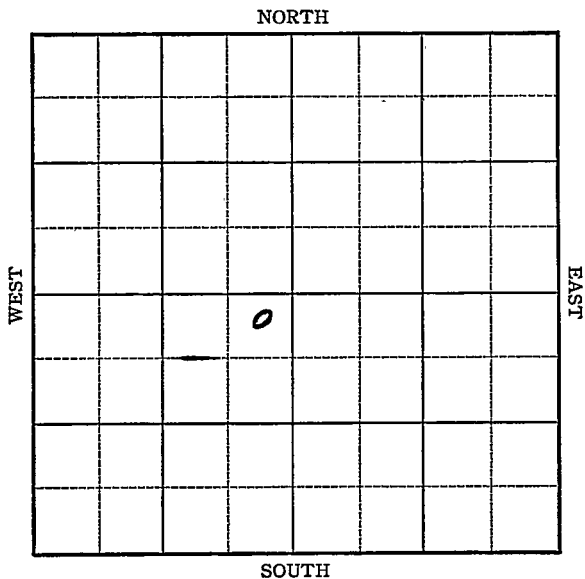


KANSAS

Grant

Section 2 Township 30 Range 35WWell No. #1 TaylorCompany United Producing

Grant **KANSAS**Map No. _____ Sec. 2 Twp. 30 R. 35WWell No. 1 Taylor

_____ United Producing _____ Company

_____ Contractor

FIRST REPORT
NE SW**SECTION PLAT**

	0		

_____ Ft. from N. Line

2515 Ft. from S. Line

_____ Ft. from E. Line

2515 Ft. from W. LineLocation X

Rig up _____

Drilling and Remarks:

RECORD

Cased _____ in., _____ ft.

Sand _____

Gas _____

Oil _____

Total Depth _____

PRODUCTION

1st 24 hrs. Nat. _____

1st 24 hrs. after shot _____

Gas _____ Cu. Ft.

Dry Hole _____

Abandoned _____

Date

OCT 20 1937 19 H. D. Hatfield Scout

Grant **KANSAS**Map No. N/M Sec. 2 Twp. 30 R. 35WWell No. 1 TaylorUnited Producing CompanyContractor**COMPLETED****NE SW** Ft. from N. Line2515 Ft. from S. Line Ft. from E. Line2515 Ft. from W. Line**SECTION PLAT**

	0		

Location Rig up

Drilling and Remarks:

4 1/2 M.**RECORD**Cased 7 in. 2520 ft.Sand ?Gas Oil Total Depth 2720**PRODUCTION**1st 24 hrs. Nat. 1st 24 hrs. after shot Gas Cu. Ft.Dry Hole Abandoned

Date

DEC 8 - 193719H. D. HatfieldScout