


Section 2 Township 30 Range 32W
Well No. 1 McCoy
Company Wm. Graham

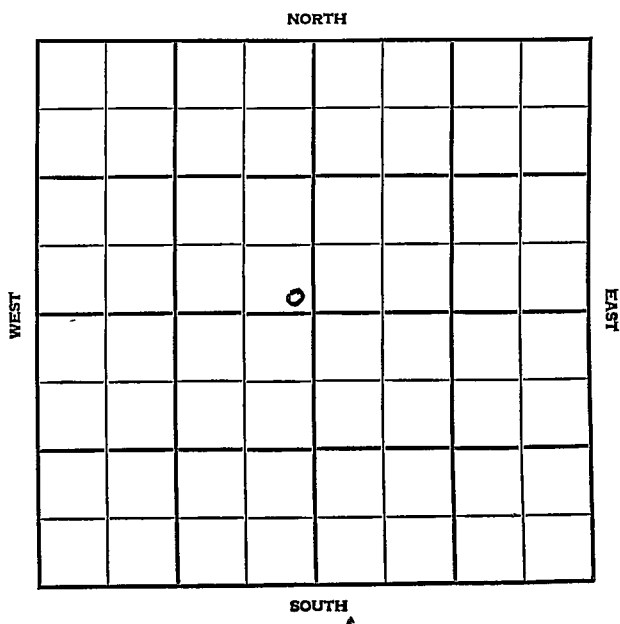

SEC.	TWP.	R.
2	30	32W
WELL NO.		
#1 McCoy		
COMPANY		FARM
Wm. Graham		
CONTRACTOR		

Co. Tools.


Hugoton Pool NORTH

_____ Ft. from N. Line

100 _____ Ft. from S. Line

100 _____ Ft. from E. Line

_____ Ft. from W. Line

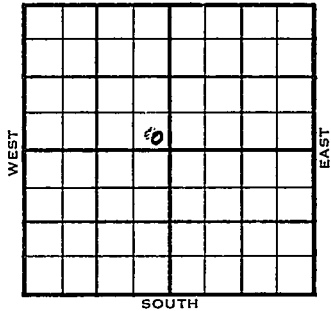

SE SE NW

	ELEVATION	REPORT
1954	2882'	
10/27	Spud 10-14-54 8" @ 590' TD 2672' 5" @ 2672'	
11/10	Spud 10-14-54 Gas Well TD 2762' 8" @ 590' Her. 2644', Kri 2680', Win 2752' TD 2762' 5" @ 2762' 80/ 2712-32 500 A 40/ 2680-90 500 A 1,250,000 cfg. A-frac. 2,000,000 cfg. Comp open flow 6,000,000 cfgpd	

COMPLETED

FABEN GILSTRAP

FABEN GILSTRAP