


Section 2 Township 30 Range 4-W

Well No. 1 - Baird


Company Magnolia

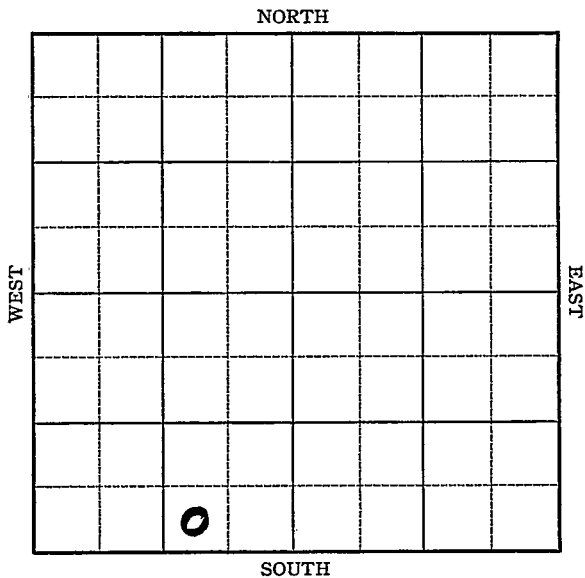

Sec. 2 Twp. 30 R. 4-W

Well No. #1 Baird Farm  
Magnolia Company

\_\_\_\_\_ Ft. from N. Line  
330 Ft. from S. Line  
990 Ft. from E. Line  
 \_\_\_\_\_ Ft. from W. Line

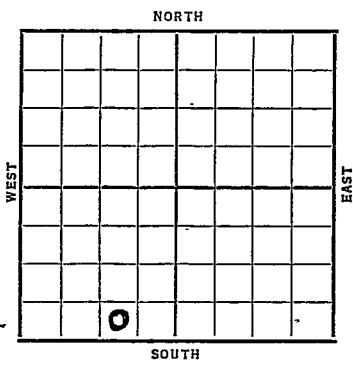

Elev. 1387

Date	REPORT
1937	
9/8	B. R. R.
9/17	16" @ 295'. WOC.
9/24	Drlg. 1761'.
10/2	Drlg. 2955'.
10/8	K.C. 3345'. Drlg. 3687'.
	No shows.
10/16	<del>Top Bartlesville 4310</del> BASE Miss. line 4310
	Top Simpson 4394
	Cored 4397-4401 Full recover
	Good stain oil Coring ahead (Tel)
10/15	Chat 3968 Dlg. 4375 No shows
10/16	<del>Top Bartlesville 4310</del> BASE Miss. 4310
	Top Simpson 4394
	Cored 4397-4401--full recovery
	Good stain oil Coring ahead (Tel)
10/18	Correction--Bartlesville sand at 4310
	Should have been base Miss. lime
	(Note from Hatfield)

**OVER**

**OVER**

- 10/22--Simpson 4394-4401 TD 7" 4394  
 Drilled plugs Total fill up 4150 feet  
 of fluid Swabbed for 11 hours Down  
 3 hours Swabbed 168 bbls. oil and 278  
 bbls. water Lowered fluid to 3400 feet  
 Still testing (Tel)
- 10/23--Yesterday swab 500 bbls. oil and 976  
 bbls. water in 16 hours  
 Gravity 43 (Tel)
- 10/27--Swabbed 782 bbls. oil and 1500 bbls.  
 water in 20 hours Swabbing 2400 feet  
 off bottom Will plug back to bottom  
 pipe and drill out (Tel)
- 11/5--T.D. 4401 7" 4394 PB to 4394 and  
 drilled out 1 foot to 4395.  
 Making  $4\frac{1}{2}$  bbls. oil and  $1\frac{1}{2}$  bailers water  
 per hour (Tel)
- 11/12 T.D. 4395'. 1200' Fluid 5 hrs.  
 Swab 110 bbls. oil & 16 water.  
 Pump 158 oil & 11 water 24 hrs.
- 11/13--T.D. 4395 Potential gauge  
 1st 4 hours pump 63 bbls.  
 2nd 4 " " 67 "  
 Potential 378 bbls. oil and  $2\frac{1}{2}$  bbls.  
 water (Tel)
- 11/17 7" @ 4394'.  
 Simp. 4394'.  
 T.D. 4401'.  
 P.P. 4395'.  
 Potential 378 oil &  $2\frac{1}{2}$  water.

COMPLETED

Map No. 37 Sec. 2 Twp. 30 R. 4W

Well No. 1-Baird

Magnolia

Company

Contractor

**FIRST REPORT**

**SECTION PLAT**


\_\_\_\_\_ Ft. from N. Line

330 Ft. from S. Line

990 Ft. from E. Line

\_\_\_\_\_ Ft. from W. Line

Location \_\_\_\_\_

Rig up \_\_\_\_\_

Drilling and Remarks:

*B.P.R.*

**RECORD**

Cased \_\_\_\_\_ in., \_\_\_\_\_ ft.

Sand \_\_\_\_\_

Gas \_\_\_\_\_

Oil \_\_\_\_\_

Total Depth \_\_\_\_\_

**PRODUCTION**

1st 24-hrs. Nat. \_\_\_\_\_

1st 24 hrs. after shot \_\_\_\_\_

Gas \_\_\_\_\_ Cu. Ft.

Dry Hole \_\_\_\_\_

Abandoned \_\_\_\_\_

Date

SEP 8 1987 19

H. D. Hatfield

Scout

