Kingman

KANSAS

2 30S 7W

SECTION TOWNSHIP RANGE

WELL NO. #1 Sankey Coberly

COMPANY Pure Oil Co.

C NW SW

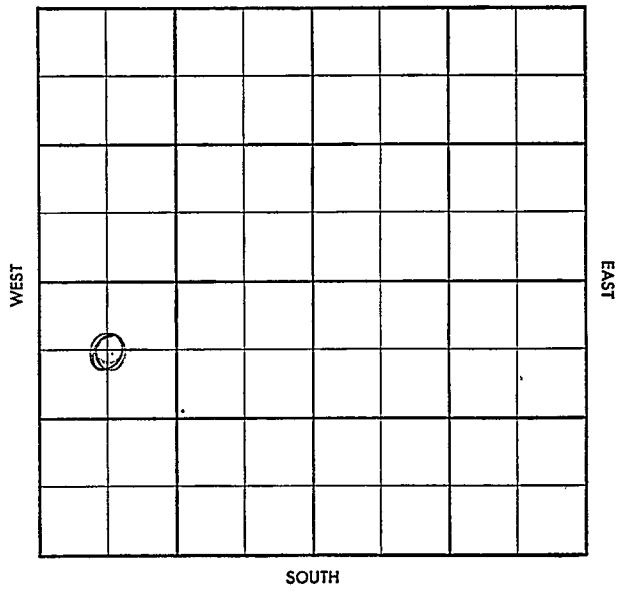

Gitchell

27

S-513-A

CO. Kingman ELEV. _____

SEC. 2 TWP. 30S RGE. 7W

COMPANY Pure Oil Co. NO. 1

FARM Sankey Coberly

LOC. C NW SW

GEOL. _____

CONTR. Garvey

POOL Trenton So.

SPUD Loc.

NOV 6 57

FIRST REPORT

o			

CO. T

LSE.

NO.

SEC.

TWP.

RGE.

~~Gilchrist~~

S-513-A

CO. Kingman ELEV. 1501 DF

SEC. 2 TWP. 30S RGE. 7W

COMPANY Pure Oil Co. NO. 1

COMPLETE

JAN 15 '58

FARM Sankey Coberly

LOC. C NW SW

GEOL.

CONTR. Garvey

POOL Trenton So.

SPUD Loc. 11-11-57

NO. 26 '57 8" 268/225

Ø 2975

losscir 3710

M 4150 DST

4153-76 /20"

g/70" JSTM

TD 4246

240' H06 gcm FP 72-92

BHP 1190-550/20"

DST 4177-4200 90"

g/45" 300 gssy mc 060'

W FP 55-165 BHP 590

-1138/30" TD 4246 run log

5½ 4245/125 PB 4208

56/454-68 $ 10CBM 10hrs

250A 10 X10 $Ld

$ 30 BO + 320 BW 24hrs

56/4190-4204 $ 12BW

NT SQ PB 4181 40/4154-64

$ show oil ½ BW 5hrs

frac $ Ld $100

BO +105BW 16hrs pop

DEC 26 '57 P 22BO +120BW 24hrs

P 46BO +110 BW 24hrs

JAN 2 '58 P 35BO +95BW 24hrs

P 38BO +90BW 24hrs

P 54BO +80BW 24hrs

JAN 8 '58 P 54BO +95BW 24hrs

P 51BO +90BW 24hrs

JAN 15 '58 51BO +100BW pd

Gr 32°

Miss

Log tops

H 3110

Dg 3140

L 3342

Kc 3618

Bkc 3870

Ce 4060

M 4152

CO. LSE. NO. SEC. TWP. RGE.