

KIOWA

KANSAS

20

30S

16W

SECTION _____ TOWNSHIP _____ RANGE _____

#1-20 Robbins Unit

WELL NO. _____

Shell Oil Co.


COMPANY _____

NORTH

C SE/4

WEST

EAST

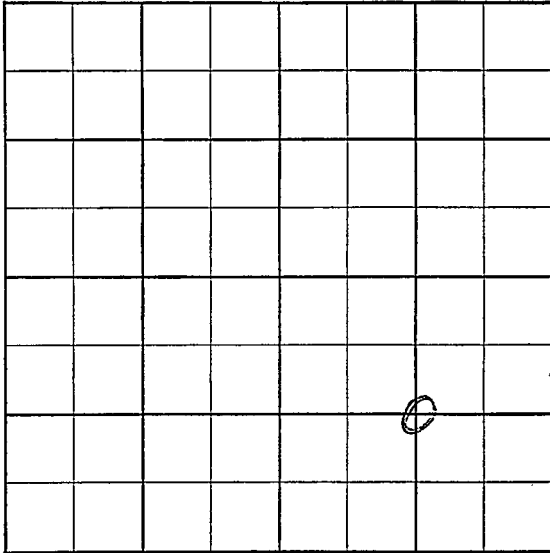

SOUTH

DEC 18 57

Loc. C SE/4 (app) 1320' fsl x 1220' fw1
SE/4

[illegible]

GEOL.

CONTR.

POOL Glick

SPUD

Location

CO.

USE

No.

SE

TWP

RGF

S-513-A

CO. KiowaELEV. 20060

COMPLETE

SEC. 20TWP. 30RGE. 16W

FEB 5 '58

COMPANY Shell Oil Co. NO. 1-20FARM Robbins UnitLOC. C 3 1/4 (app) 1320' fsl x 1220' fwl

SL/L

GEOL.

CONTR.

POOL GlickSPUD 12-22-57Location DEC 25 '57 8"

JAN 2 '58

JAN 8 '58

JAN 15 '58

5" 4925/150515/1000 wocØ 3405Ø 4904run Log5" 4925/150H 4029L 1cc 4218M 4785TD 4936Log H 4029 L 1cc K 4219M Chert 4785 K 4914CO 4891 156/4807 = 4632/4792-4800 (K) Flo 5.500meif 1" ch k 10 hrs SI 6 hrsSI CP 1550 flow 20x20SI 12 hrs Flo 5.500 meif1" ch k 8 hrs FTP 350 CP1000 sep P 60 SIJAN 29 '58 FEB 5 '58 Ca op Flo 17.000meif SI P 1533