


KANSAS

Kiowa

Section 20 Township 30 Range 20-WWell No. #1 Lormier (Lorimer)Company ~~Pine Drig.~~ Drillers Gas

NORTH

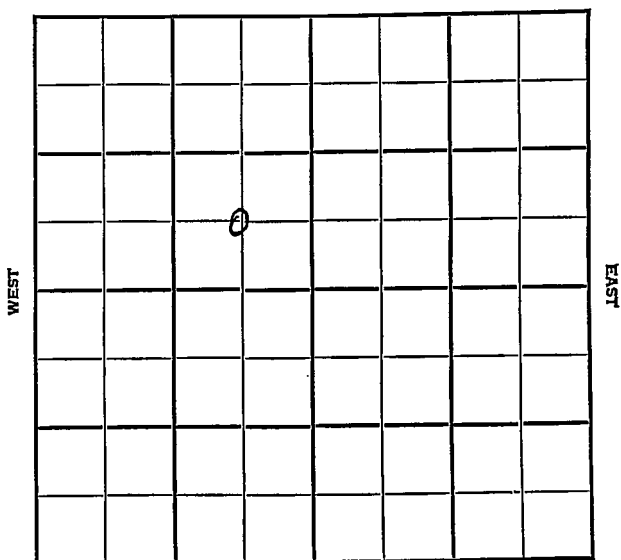

SOUTH

KANSAS

Kiowa

Sec. 20 Twp. 30 R. 20W ✓

Well No. #1 Lormier Farm

Rine Drlg. Drillers Gas Company

C SE NW


 Ft. from N. Line

660' Ft. from S. Line

660' Ft. from E. Line

 Ft. from W. Line

C SE NW

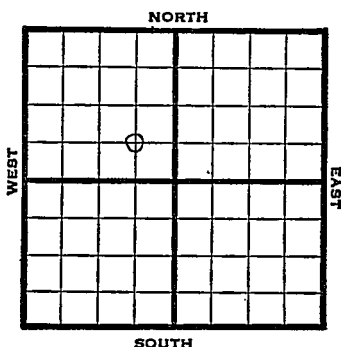

1948

Elev. 2230' REPORT

5/5	RUR	
5/12	8" @ 730'	
	Drlg. 1210'	
5/19	Drlg. 4160'	
5/26	Lansing 4130'	
	Miss. 5156'	
	Drlg. 5260'	
6/1	TD 5278'	
6/9	5" @ 5274'	
6/16	84 shots 5126-54 swb 6 bbls	
	oil & 3 W in 18 hrs.	
6/23	3000 Acid	
	P&F 88 bbls oil & 14 W in 12 hrs	
	Gravity 33	
6/29	Pump & Flow 307 bbls oil trace	
	water 24 hrs.	
7/8	"	"
7/14	"	"
7/21	"	"
7/28	"	"
8/4	"	"
8/11	"	"

OVER

1948

8/18 Pump p & flow 307 bbls oil trace wtr
24 hrs.

8/25 " "

9/1 " "

9/8 Miss 5156'
5" @ 5274'
TD 5278'
Pump 219 oil & 22 W Pot.
Gr. 330

COMPLETED

Wildcat

Map No. _____ Sec. 20 Twp. 30 R. 20W


Well No. 1 Lormier

Rine Drlg. _____ Company

FIRST REPORT

_____ Contractor
C SE NW

SECTION PLAT

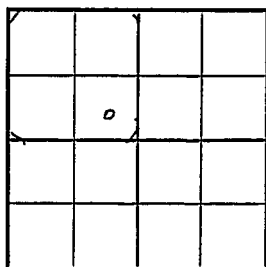

_____ Ft. from N. Line

660 Ft. from S. Line

660 Ft. from E. Line

_____ Ft. from W. Line

Kiowa County

Location _____

Rig up _____

Drilling and Remarks:

R U R

RECORD

Cased _____ in., _____ ft.

Sand _____

Gas _____

Oil _____

Total Depth _____

PRODUCTION

1st 24 hrs. Nat. _____

1st 24 hrs. after shot _____

Gas _____ Cu. Ft.

Dry Hole _____

Abandoned _____

Date

MAY 5 1948 19

S. J. LEWIS Scout







 







Misc. Small Maps	
Cards	
Tracing	
France Map	
Scarborough Map	
Pierce Map	
Geological Dept	
Pierce Map	


Map No. 90 Sec. 20 Twp. 30 R. 20WWell No. 1 Lormier

Drillers Gas

Company

CORRECTION

; Contractor

C SE NW

SECTION PLAT

	o		

Ft. from N. Line

660 Ft. from S. Line660 Ft. from E. Line

Ft. from W. Line

Kiowa County

Location

Rig up

Drilling and Remarks:

Drillers Gas has
taken this over
from Rine Drlg.

RECORD

Cased _____ in., _____ ft.

Sand _____

Gas _____

Oil _____

Total Depth _____

PRODUCTION

1st 24 hrs. Nat. _____

1st 24 hrs. after shot _____

Gas _____ Cu. Ft.

Dry Hole _____

Abandoned _____

Date

JUN 1 1948 19

S. J. LEWIS

Scout

Misc. Small Maps	_____
Cards	_____
Tracing	_____
France Map	_____
Scarborough Map	_____
Pierce Map	_____
Geological Dept.	_____
Pierce Plat Book	_____

Kiowa County Kansas State
 Map No. 90 Sec. 20 Twp. 30 R. 20W

Well No. 1 Lormier


Drillers Gas Company

COMPLETE

Contractor

C SE NW

E 12280
 SECTION PLAT

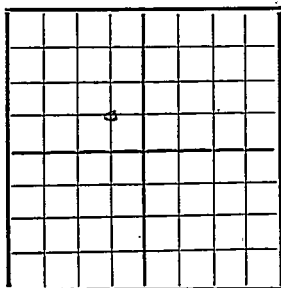

 Ft. from N. Line

660 Ft. from S. Line

660 Ft. from E. Line

 Ft. from W. Line

Excel Pool

Remarks:

Miss 5156

5105274

7715278

Pump 219 oil + 22 WD

33° E

Date
 SEP 8 1948

Scout S. J. LEWIS

Misc. Small Maps	
Cards	<u>OS</u>
Tracing	<u>OS</u>
France Map	<u>OS</u>
Scarborough Map	<u>OS</u>
Pierce Map	<u>L</u>
Geological Dept.	
Pierce Plot Book	