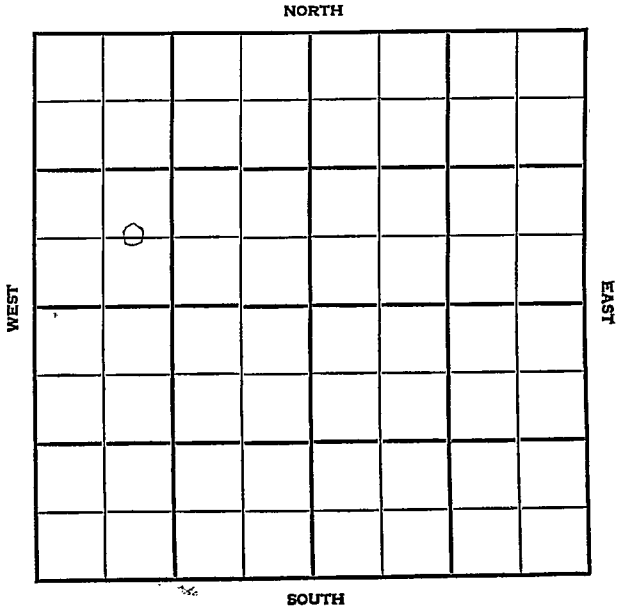


Section 20 Township 30 Range 20WWell No. #2 LorimorCompany M. B. Armer et al

Kiowa

KANSAS

SEC.	TWP.	R.
20	30	20W

WELL NO. 2 Lorimor FARM

COMPANY M. B. Armer et al

CONTRACTOR Co. Tools

Excel


_____ Ft. from N. Line

_____ Ft. from S. Line

_____ Ft. from E. Line

_____ Ft. from W. Line

C E $\frac{1}{2}$ SW NW

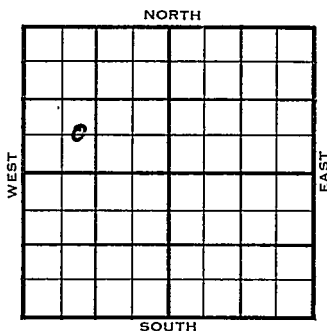

	ELEVATION	REPORT
1955	2282	

6/15 Comm 6-9-55
8" @ 308/225
Anh 1270
Drlg 2845

6/29 Comm 6-9-55
Anh 1270
H 4309
TD 5265
8" @ 308 w/225, DST 5170-90 op 2 hrs
Rec 30' m BHP 154/30, DST 5190-5200
op 2 hrs Rec 20' M F $\frac{1}{2}$ O# BHP 75/30"
D & A

ABANDONED

County Kiowa ✓

Elev.

Sec. 20 Twp. 30 Rge. 20WCompany M. R. Armer et al.Farm Name Lorimer No. 2

TOPS

DEPTH

LOG

DATUM

Loc. in Sec.

Anh.	1270			C E $\frac{1}{2}$ SW NW
Tr.				
H.				
Tr.				
Dg.				
BL.				
L.				
K.C.				Geol.
B.K.C.				Contr.
Ce.				Co. tools
C.				Pool
M.				Excel
Mz.				
Me.				
V.				
S.				
S.				
A.				
R.				
PE.				
G.				
TD.				

Date Comm. 6-9-558th @ 308/225 drlg. 2845

K-25 ✓

FIRST REPORT
JUN 15 55

County Kiowa Elev. 2282
 Sec. 20 Twp. 30 Rge. 20W
 Company M. B. Armer et al
 Farm Name Lorimor No. 2

TOPS	DEPTH	LOG	DATUM
Anh.	1270		
Tr.			
H.	4309		2027
Tr.			
Dg.			
BL.		4485	2203
L.			
K.C.		4497	2215
B.K.C.			
Ce.			
C.			
M.		5173	2891
M.			
K.			
Mz.			
Mq.			
V.			
S.			
S.			
A.			
R.			
PE.			
G.			
T.D.	5265		

Loc. in Sec. C E/2 SW NW


Geol. _____

Contr. _____

Co. tools _____

Pool _____

Excel _____

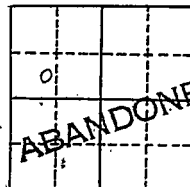

Date Comm. 6-9-55

8" 308 w/225, DST 5170-90 op 2 hrs Rec. 30'

M BHP 154/30, DST 5190-5200 op 2 hrs Rec 20'

M FP 0#, BHP 75/30"

D & A