


Section 20 Township 30 Range 14-W

Well No. #1 Werner

Company Great Lakes Carbon et al

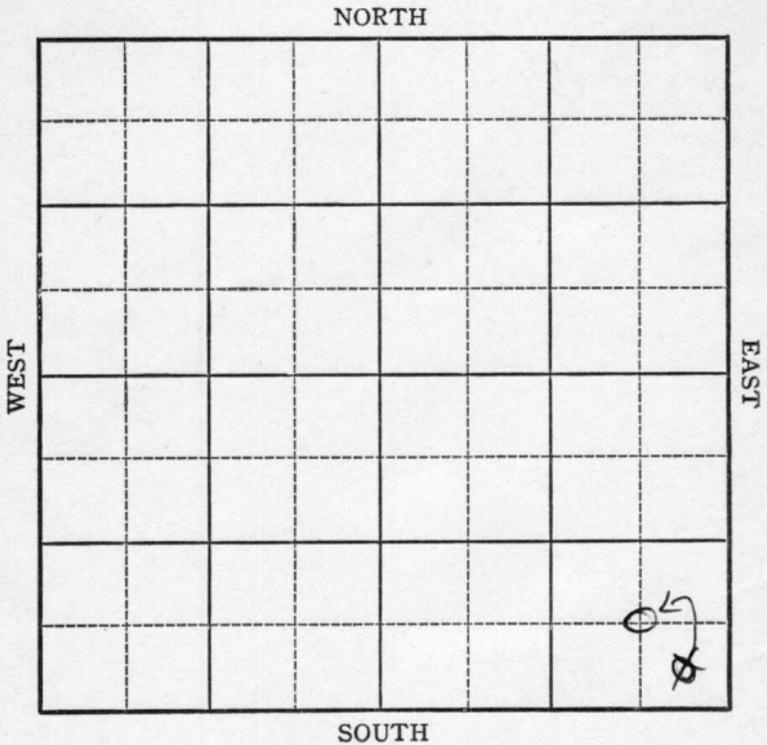

Sec. 20 Twp. 30 R. 14-W

Well No. #1 Werner Farm

Great Lakes Carbon et al Company

(Wildcat)

Ft. from N. Line

660'

~~330~~

Ft. from S. Line


660'

~~330~~

Ft. from E. Line

Ft. from W. Line

Elv. 1883

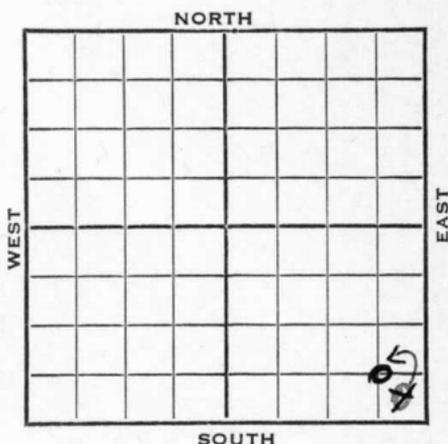

1942

REPORT

7/15	Location
7/22	Derrick
7/29	10" - 194 Anhy 750' Drlg. 1830'
8/5	Ft. Riley 2300 Drlg. 2440'
8/12	Topeka 3170 Drlg. 3722
8/19	Lans. 3993 Drlg. 4494'
8/27	No Miss Viola 4488 Simp 4572 SSO 4572-93 Arb. 4676 TD 4702 No shows Run 5"
9/2	" " "
9/9	" " "
9/16	Plug 4580 SSO & G 4570-80 CO
9/23	500 acid SSO & G. 200' water C.O.
9/30	TD 4580 Prep to PB Shot 10 qts. 4572-78 HFW
10/7	" " " "
10/14	Arb. 4676 5" - 4572 Water T.D. 4702

ABANDONED

Barber KANSAS

Map No. 92 Sec. 20 Twp. 30 R. 14W

Well No. 1 Werner

Great Lakes Carbon et al. Company

FIRST REPORT

Contractor

SE/C

SECTION PLAT

 Ft. from N. Line

330 Ft. from S. Line

330 Ft. from E. Line

 Ft. from W. Line

			o

WILDCAT

Location XXX

Rig up

Drilling and Remarks:

RECORD

Cased in., ft.

Sand

Gas

Oil

Total Depth

PRODUCTION

1st 24 hrs. Nat.

1st 24 hrs. after shot

Gas Cu. Ft.

Dry Hole

Abandoned

Date

JUL 15 1942 19

S. J. LEWIS Scout

KANSAS

Barber

Map No. 92 Sec. 20 Twp. 30 R. 14W

Well No. 1 Werner

Great Lakes Carbon et al. company

Contractor

C S E SE

SECTION PLAT

			o

_____ Ft. from N. Line

660 Ft. from S. Line

660 Ft. from E. Line

_____ Ft. from W. Line

WILDCAT

Location _____

Rig up _____

Drilling and Remarks:

Reported SE/C

RECORD

Cased _____ in., _____ ft.

Sand _____

Gas _____

Oil _____

Total Depth _____

PRODUCTION

1st 24 hrs. Nat. _____

1st 24 hrs. after shot _____

Gas _____ Cu. Ft.

Dry Hole _____

Abandoned _____

Date

July 24 1942

S. J. LEWIS Scout

Barber

Map No. 92 Sec. 20 Twp. 30 R. 14W

Well No. 1 Werner

Great Lakes Carbon eta Company

ABANDONED

Contractor

C S E S E

SECTION PLAT

_____ Ft. from N. Line

660 Ft. from S. Line

660 Ft. from E. Line

_____ Ft. from W. Line

			o

WILDCAT

Location _____

Rig up _____

Drilling and Remarks:

*Cor 84676.
5" @ 4572
No test.*

RECORD

Cased _____ in., _____ ft.

Sand _____

Gas _____

Oil _____

Total Depth 4702

PRODUCTION

1st 24 hrs. Nat. _____

1st 24 hrs. after shot _____

Gas _____ Cu. Ft.

Dry Hole _____

Abandoned _____

Date

OCT 14 1942

19

S. J. LEWIS

Scout