


Section 20 Township 30 Range 13W

Well No. #1 Lemon "C"

Company Lion Oil Ref.

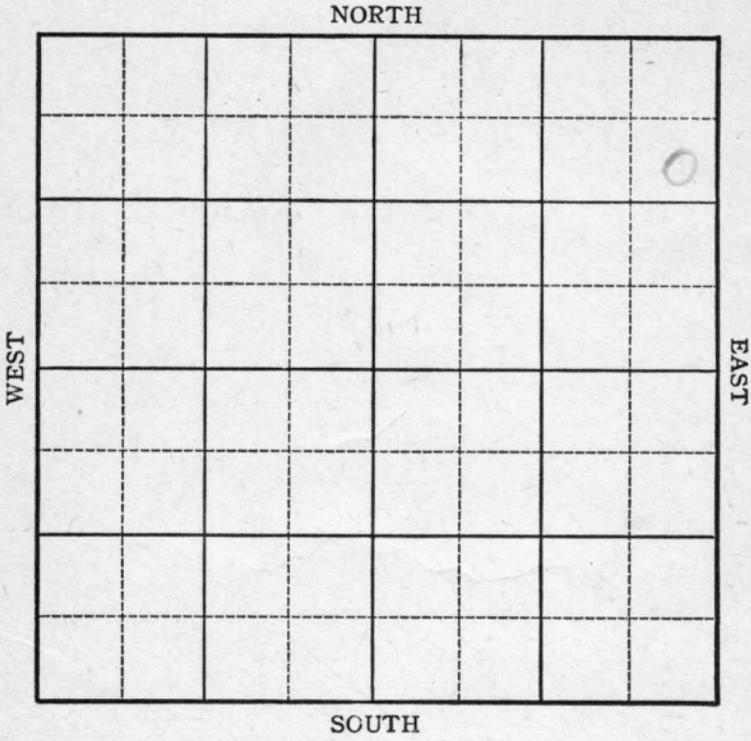

Sec. _____ Twp. _____ R. _____

Well No. #1, Lemon "C" Farm _____

Lion Oil Ref. Company _____

Marjorie

990 Ft. from N. Line


_____ Ft. from S. Line

_____ Ft. from E. Line

330

_____ Ft. from W. Line

SE NE NE Elev. 1794

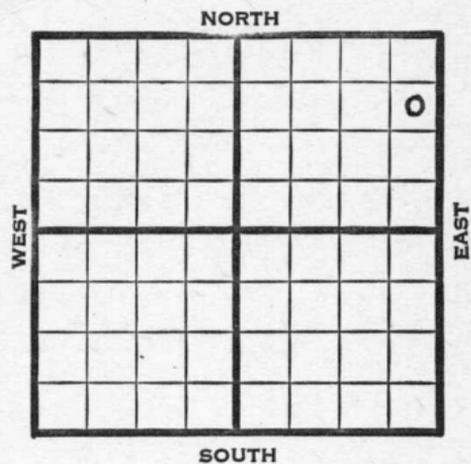

1945

REPORT

4-4	Location
4/12	Derrick
4/20	Surface Hole
4/27	Drlg. 2800'
5/3	8" @ 580
	Drlg. 4310
5/10	Lans 3899
	Miss Chert 4347
	B Chert 4375
	TD 4478
	Lost Circulation
5/17	" " " "
5/24	" " " "
5/31	" " " "
6/8	Simp sh 4548 Sd 4572 Arb. 4639
	TD. 4643 Stains 5" @ 4641 RUST
6/14	" " " " "
6/21	4480 squeeze
6/28	35 shots 4452-56
	2000 acid shots swb 2 fluid PH
	SSO & G
7/3	9500 acid.
7/11	32 shots 4460-4466
	6000 acid.
7/18	Arb. 4639
	5" @ 4641'
	TD 4643'

ABANDONED

Pool Name Marjorie

Map No. K92 Sec. 20 Twp. 30 R. 13W

Well No. 1 Lemon "C"

Lion Oil Ref. Company

FIRST REPORT

Contractor

SE NE NE


SECTION PLAT

990 Ft. from N. Line

_____ Ft. from S. Line

_____ Ft. from E. Line

330 Ft. from W. Line

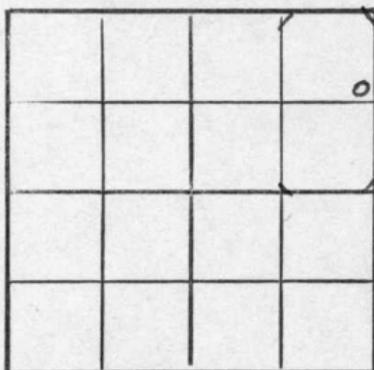

Barber County

Location X

Rig up _____

Drilling and Remarks:

RECORD

Cased _____ in., _____ ft.

Sand _____

Gas _____

Oil _____

Total Depth _____

PRODUCTION

1st 24 hrs. Nat. _____

1st 24 hrs. after shot _____

Gas _____ Cu. Ft.

Dry Hole _____

Abandoned _____

Date

APR 4 1945 19

S. J. LEWIS Scout

KANSAS Pool Name Marjorie

Map No. 1292 Sec. 20 Twp. 30 R. 13W

Well No. 1 Lemon "C"

Lion Oil Ref. Company

ABANDONED

Contractor

SE NE NE

E 11794
SECTION PLAT

990 Ft. from N. Line

_____ Ft. from S. Line

_____ Ft. from E. Line

330 Ft. from W. Line

Barber County

Location _____

Rig up _____

Drilling and Remarks:

CR Y4639

51104641

RECORD

Cased _____ in., _____ ft.

Sand _____

Gas _____

Oil _____

Total Depth 4643

PRODUCTION

1st 24 hrs. Nat. _____

1st 24 hrs. after shot _____

Gas _____ Cu. Ft.

Dry Hole _____

Abandoned _____

Date

JUL 1 8 1945 19

S. J. LEWIS Scout