FORM 51 5M 11-44 PETROL


Grant County

KANSAS

Section 20 Township 30 Range 36W

Well No. #1 Thurow

Company United Prod.

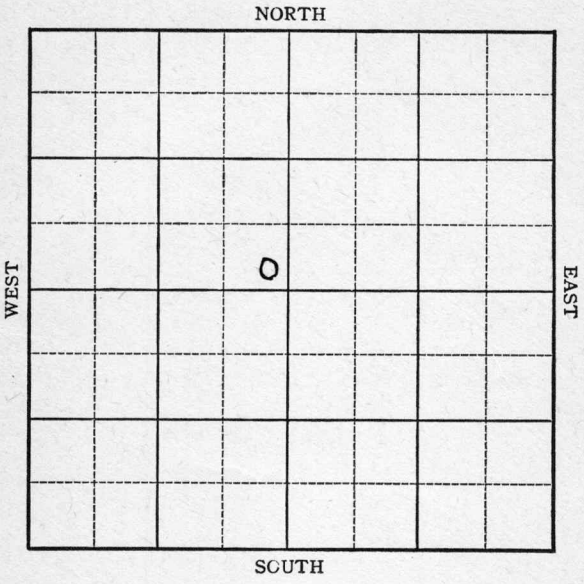

FORM 252-A
5M 8-45 PETROL

Grant County ✓

Sec. 20 KANSAS Twp. 30 R. 36-W

Well No. #1 Thurow Farm

United Prod Company


Hugoton

_____ Ft. from N. Line

100 Ft. from S. Line

100 Ft. from E. Line

_____ Ft. from W. Line

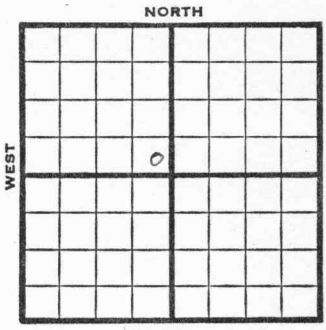

SE N W

1946	Elev. 2988 REPORT
6/19	RUR
6/26	Drlg 560'
7/3	10" @ 577' Drlg 1925'
7/9	TD 2436 7" @ 2435 RUST
7/16	Drlg 2510'
7/23	TD 2660' 254' of 5" Perf liner @ 2660 3000 acid
7/30	" " "
8/14	7" @ 2435 254' of 5" perf. liner @ 2660 12,500 acid. TD 2660 10,100,000 Gas. 408 # R Pr.

COMPLETED

FORM 26 200 BKS. 2-44 PETROL

no map
KANSAS

Kansas Pool Name Hugoton

Map No. Sec. 20 Twp. 30 R. 36W

Well No. 1 Thurow


United Prod. Company

FIRST REPORT

Contractor

SE NW

SECTION PLAT

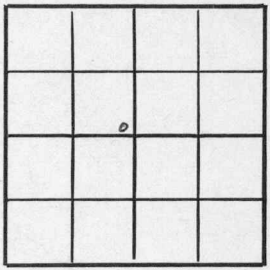

Ft. from N. Line

100 Ft. from S. Line

100 Ft. from E. Line

Ft. from W. Line

Grant County

Location

Rig up

Drilling and Remarks:

RUR

RECORD

Cased in., ft.

Sand

Gas

Oil

Total Depth

PRODUCTION

1st 24 hrs. Nat.

1st 24 hrs. after shot

Gas Cu. Ft.

Dry Hole

Abandoned

Date

JUN 19 1946 19

S. J. LEWIS Scout

FORM 26 200 BKS. 2-44 PETROL

KANSAS Kansas Pool Name Hugoton Pool

Map No. Sec. 20 Twp. 30 R. 36W

Well No. 1 Thurrow


United Prod. Company

COMPLETED Contractor

SE NW

El. 2988'

SECTION PLAT

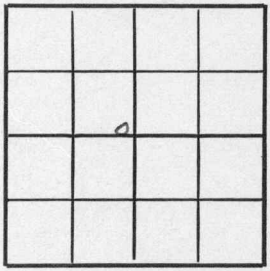

Ft. from N. Line

100 Ft. from S. Line

100 Ft. from E. Line

Ft. from W. Line

Grant County

Location

Rig up

Drilling and Remarks:

7" @ 2435

2543' 5½" Prod. line @ 2660

2660

12500 Rock

10,100,000 Gas

405# R/P

RECORD

Cased in., ft.

Sand

Gas

Oil

Total Depth 2660

PRODUCTION

1st 24 hrs. Nat.

1st 24 hrs. after shot

Gas Cu. Ft.

Dry Hole

Abandoned

Date

AUG 14 1946 19

S. J. LEWIS Scout