


DX 78-1 Kingman

Section 20 Township 30 Range 7W

Well No. #2 James G. Schuman

Company Magnolia Petroleum

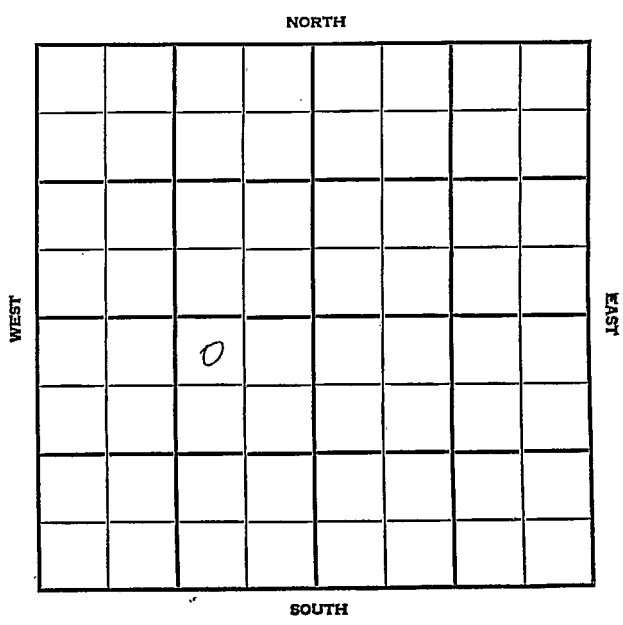

Kingman

KANSAS

SEC.

20

TWP.

30

R.

7W

WELL NO.

#2 James G. Schuman

FARM

COMPANY

Magnolia Petroleum

CONTRACTOR

Graham-Michaelis
Spivey-Grabs

____ FT. FROM N. LINE

____ FT. FROM S. LINE

____ FT. FROM E. LINE

____ FT. FROM W. LINE

NW NE SW

NORTH

WEST

EAST

SOUTH

ELEVATION

1956

REPORT

8-22

Loc.

County Kingman Elev. _____
Sec. 20 Twp. 30 Rge. 7W
Company Magnolia Petroleum
Farm Name James G. Schuman No. 2

TOPS	DEPTH	LOG	DATUM
Anh.			
Tr.			
H.			
Tr.			
Dg.			
BL.			
L.			
K.C.			
B.K.C.			
Ce.			
C.			
M.			
M.			
K.			
Mz.			
Me.			
V.			
S.			
S.			
A.			
R.			
Pe.			
G.			
T.D.			

Loc. in Sec. NW NE SW

Geol. _____

Contr. Graham-

Michaelis

Pool Spivey-Grabs

FIRST REPORT	
0	
AUG 22 '56	

Date Comm. _____
Location _____

5201 0 S 0UA

County Kingman Elev. 1552
 Sec. 20 Twp. 30 Rge. 7W
 Company Magnolia Petroleum
 Farm Name James G. Schuman No. 2

TOPS	DEPTH	LOG	DATUM	Loc. in Sec.
Anh.				NW 1/4 SW
TP.				
H.		3207		
Tr.				
Dg.				
Bl.				
L.				
K.C.		3432		Geol.
B.K.C.				Contr.
Ce.				Graham-
C.				Michaelis
M.		4247		Pool
M.				Spivey-Grabs
K.				
Mz.				
Mo.				
V.				
S.				
S.				
A.				
R.				
Pe.				
G.				
T.D.	4340			

COMPLETE

SEP 19 '56

Date Comm.

Location AUG 7 '56 8-26-569578 219/250 H 966 SEP 5 '56D 3840 SEP 12 '56 DST 4249-73or 1 in 2/7" est 25 MCF per1155' 9554 + 90' MCB + 355'H 26 CM BHP 1360/20"5 1/2 4339/200 SEP 14 '56 Co 430260/4250-62 1/4 Flwd 61 BOno/w 24 hrs 1/4" ch

FORM 513-1 SUNRAY

TP 30 CP 400 925 92
25 MCF GOR 410.1