


Kiowa

KANSAS

SECTION 21 TOWNSHIP 30S RANGE 16W

WELL NO. #1-21 Robbins Unit

COMPANY Shell Oil Co.

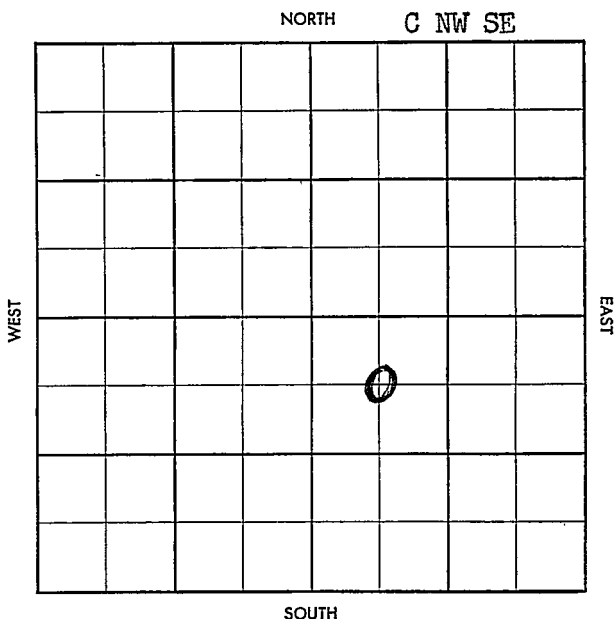

CO. Kiowa ELEV. _____SEC. 21 TWP 30 RGE. 16WCOMPANY Shell Oil Co. NO. 1-21

JAN 15 '58

FIRST REPORT

FARM Robbins UnitLOC. App C NW SE 760' fnl x 660' fwl SE/4

GEOL. _____

CONTR Garvey toolsPOOL GlickSPUD 1/10/588" @ 531 w/400 Drlg.
2577.

CO.

LSE.

NO.

SEC.

TWP.

RGE.

Twp ~~X~~ Pool ~~X~~
 Co. ~~X~~ Farm ~~X~~

CO. Kiowa ELEV. 1SEC. 21 TWP 30 RGE. 16WCOMPANY Shell Oil Co. NO. 1-21

MAY 14 '58

COMPLETE

FARM Robbins UnitLOC. App C NW SE 760' fml x 660' fwl SE/4

GEOL. _____

CONTR. Garvey toolsPOOL GlickSPUD 1/10/58

8" @ 531 w/400 Drlg.

2577. JAN 2 1958 4439

Loss circ 4380

44 42 m log

Log tops

5' 4890/150 Log

To 13 H 3994 LK 4181

m chest 4729 K 4854

to 4859 156/4814-53

PK 4785 (1/2) 1/2 onld 156 153

BL 6 + 139 mcf 130 SIP 300

Petro fuel 6 \$ 66 + gas 250

mcf PR 4500 152/4728-

66 (1/2) \$ 66 + gas + st m

Petro fuel 6 died TPOCD 600

FLO 632 mcf FTP FCP 400

FLO 744 mcf 1" chuk

FTP 50 FCP 275 SIP

1220

MAR 19 53

APR 23 50

1 58

MAR 14 58

Ca op FLO 1.125 mcf

sip 1520