


Barber

KANSAS

SECTION 21 TOWNSHIP 30 RANGE 15W

WELL NO. #1 U.S. Gypsum

COMPANY Aylward Drlg. Co.

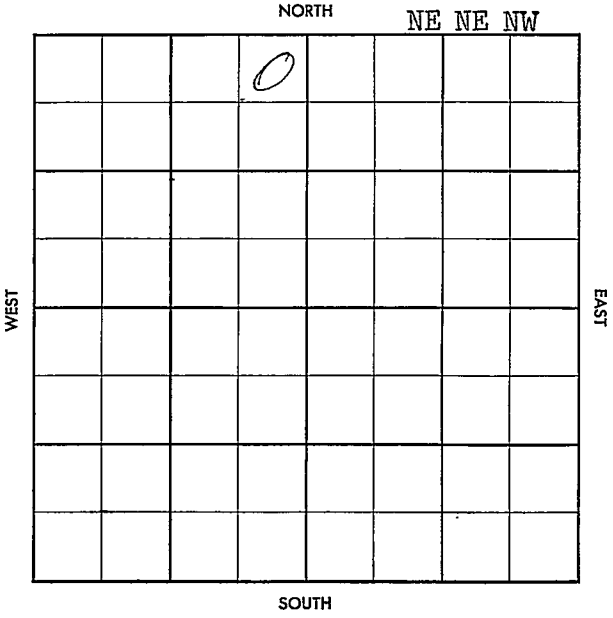

County Barber Elev. _____
 Sec. 21 Twp. 30 Rge. 15W
 Company Aylward Drig. Co.
 Farm Name U. S. Gypsum No. 1

TOPS	DEPTH	LOG	DATUM	Loc. in Sec.
Anh.				NE NE NW
Tr.				
H.				
Tr.				
Dg.				
Bl.				
L.				Geol. _____
K.C.				Contr. _____
B.K.C.				
Ce.				Co. Tools
C.				
M.				Pool
M.				Turkey Creek E
K.				
Mz.				
Me.				
V.				
S.				
S.				
A				
R.				FIRST REPORT
PE.				
G.				
T.D.				


JUN 5 1957
 FIRST REPORT

Date Comm. 5-31-57 Phillips, C.S. & Aladdin
8" @ 833/800, Drig. 2175 (DHM)

T.
 R.

County Barber Elev. 1860 DF
 Sec. 21 Twp. 30 Rge. 15J
 Company Atwood Drilling Co. E N C R A
 Farm Name U. S. Gypsum No. 1

TOPS	DEPTH	LOG	DATUM	Loc. in Sec.
Anb.				NE NE NW
Tr.				
H.	3787			
Tr.	Orlad	3824		
Dg.	sd	3842		
Bl.				
L.	3964			
K.C.				Geol.
B.K.C.	DRUM	4161		Contr.
Ce.	BKs	4372		
C.	Marm	4381		Co. Tools
M.	Massey	4462		
M.		4509		Pool
K.				
Mz.				Turkey Creek
Mo.				
V.	4568	4546		
S.	4687	4674		
S.	sd	4713		
A.		4760		
R.				
PE.				
G.				
T.D.	4798			

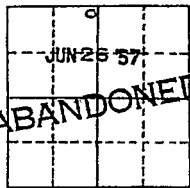

Date Comm. 5-31-57 Phillips, C.S. & Orlad in
 8" x 833/400, Drilling 2175 ft - 57 (DHP)

Ø 3970 JUN 10 '57 DST 4543-51
 90" rec 19' Md BHP 65/20"
 Ø 4575 8 5/8" DST 4562-85 1 hr
 20' Md no show BHP 48/15"
 DST 4609-26 or 30" rec 20'
 Md BHP 41/15"

DEA