


Section 21 Township 30 Range 15W

Well No. 1 Walker

Company Great Lakes Carbon

Wildcat  
NORTH

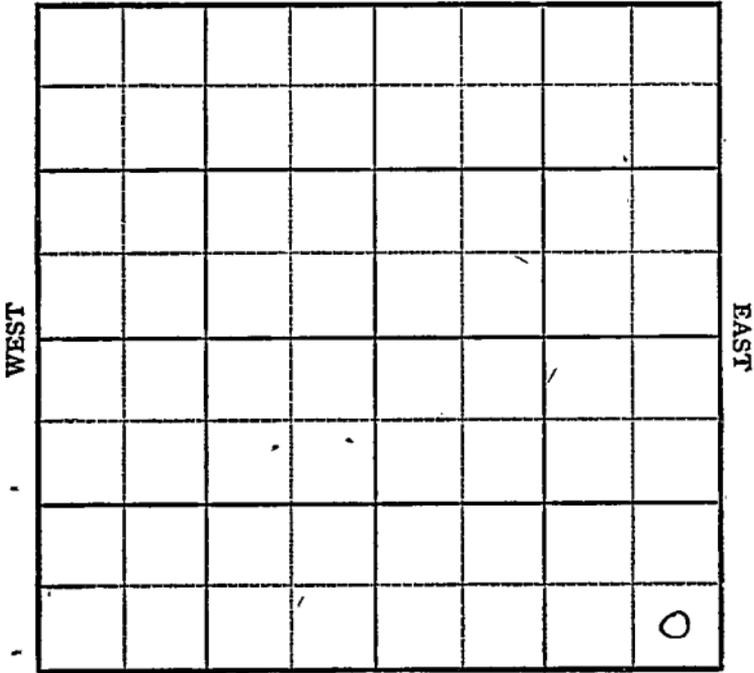

SOUTH

KANSAS

Barber

**HOT FILE**

Sec. 21 Twp. 30 R. 15W ✓

Well No. #1 Walker Farm

Great Lakes Carbon Company

Wildcat


NORTH

\_\_\_\_\_ Ft. from N. Line

330' Ft. from S. Line

330' Ft. from E. Line

\_\_\_\_\_ Ft. from W. Line

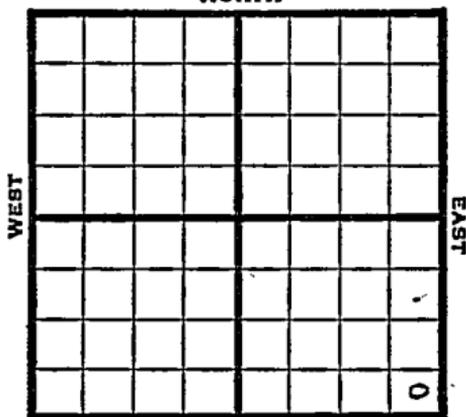

SE/c This Well 1/2 mi West of Our lease

1948

Eli 1794' REPORT

- 8/18 Location
- 8/25 RUR
- 9/1 8" @ 840'
- Drlg. 2140'
- 9/8 Drlg. 3615'
- 9/14 Lans. 2905'
- Douglas 3772'
- Drlg. 4107'
- 9/21 Viola 4460'
- Simp. 4588 ?
- Drlg. 4642'
- 9/29 TD 4734'
- Simp 4610'
- Arb. 4696'
- Aband.

**ABANDONED**

Barber County Kansas State

Map No. \_\_\_\_\_ Sec. 21 Twp. 30 R. 15W

Well No. 1 Walker

Great Lakes Carbon Company

**FIRST REPORT**

Contractor

SE/C

**SECTION PLAT**


\_\_\_\_\_ Ft. from N. Line

330 Ft. from S. Line

330 Ft. from E. Line

\_\_\_\_\_ Ft. from W. Line

Wildcat Sec. 22  
Remarks: \_\_\_\_\_

Location

Date AUG 1 8 1948 Scout S. J. LEWIS

