


SECTION 21 TOWNSHIP 30 RANGE 15W

WELL NO. #1 Walker

COMPANY Phillips Petr.

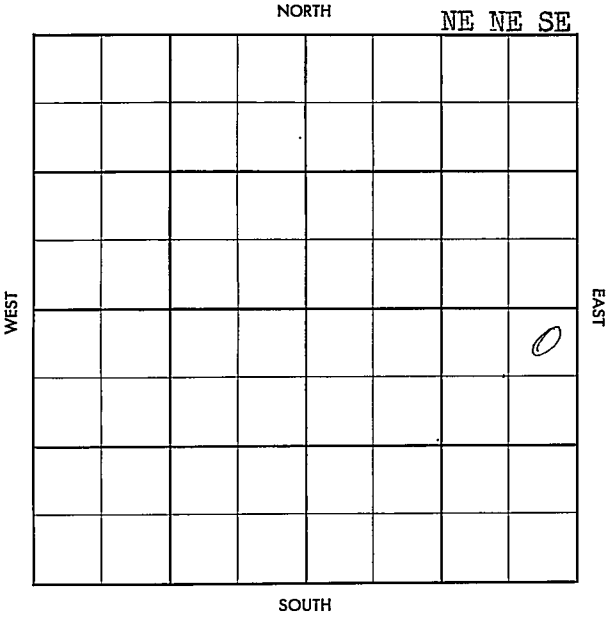



County Barber Elev. 1836  
 Sec. 21 Twp. 30 Rge. 15W  
 Company Phillips Pet.  
 Farm Name Walker No. 1

TOPS	DEPTH	LOG	DATUM
Anb.			
Tp.			
H.		3270	
Tr.		3285	
Dg.			
Bl.		3928	
L.		3942	
K.C. <u>Marm</u>		4347	
B.K.C. <u>Massey Zn</u>		4380	
Ce.			
C.			
M.		4491	
M.			
K.			
Mz.			
Mo.			
V.		4522	
S.			
S.			
A.			
R.			
PE.			
G.			
T.D.	4600		

Loc. in Sec. NE NE SE  
 Geol. \_\_\_\_\_  
 Contr. \_\_\_\_\_  
 Garvey Tools  
 Pool # 10  
 Turkey Creek NE

COMPLETE  
 JUN 12 57

Date Comm.

Location APR 17 57 4-17-57 858  
858/700 WUC APR 24 57 # 3660  
MAY 1 57 5 1/2 4600 MAY 27 57 MICT MAY 15 57  
CO 4577 72/4542-60 \$ 18.2  
B0 no/w 6 hrs 1/2 Flwd 314  
B0 + 48 BW 11 1/2 hrs Flwd  
30 1/2 B0 no/w 1 hr MAY 22 57 Flwd  
169 B0 no/w 8 hrs 2 1/4" ch  
CP 420 # TP 320 # MAY 29 57  
JUN 5 57 JUN 12 57 Ph Flow 496 B0 pd no/w