


Barber


KANSAS

SECTION 21 TOWNSHIP 30S RANGE 15W

WELL NO. #2 Walker

COMPANY Great Lakes Carbon Co.

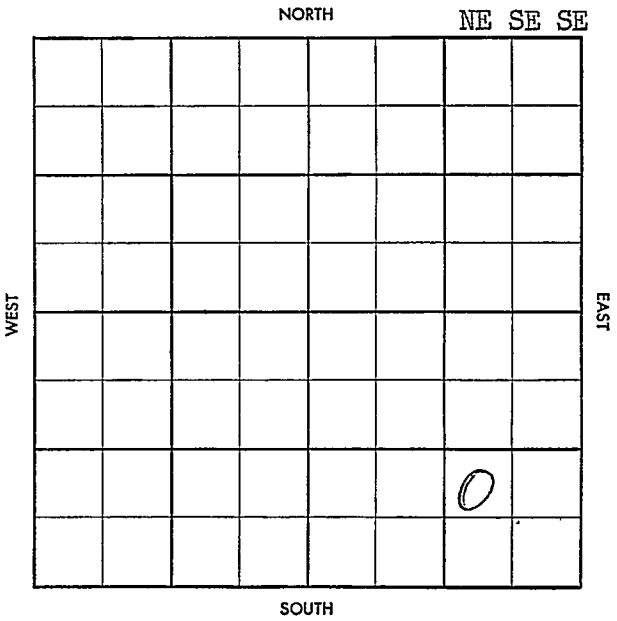

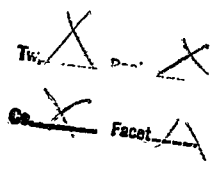

CO. Barber ELEV. 1820/1817
 SEC. 21 TWP. 30 RGE. 15W
 COMPANY Gt. Lakes Carbon No. 2

NO. 13
 COMPLETE
 JUN 25 '58

FARM Walker
 LOC. NE SE SE

BKC 4338
Macey 4368
U. 4335
TD 4553

GEOL. _____
 CONTR. Iron Drlg.
 POOL E. Turkey Creek
 SPUD 12-15-57
 8" @ 820/500
 drlg. 851
 \$ 3710
 DST 4535
 - U 560" 33'M
 FPO BHP 19-18/30

JAN 5 '58 DST 4541-53 9/37
 65' 059' cm 236' oil FP
 38-130 BHP 1500 170
 - 1320 12L Log Hb 3750
 TR 3766 Dg 3790 RL
 3891 Lsg 3919 ~~4336~~ 4336
 Macey 4366 B Perm zone
 4468 Vio zone 4506
 Cherty Vio 4532 5" 4539
 1125' MICT @ Miss 4474

JUN 15 '58 CD 4553 FU 1500' oil
 overnight \$ 2 BOPH NW
 3 hrs @ FU 1500' oil + 1 gw
 \$ 2 BOPH + trw 3 hrs pop
~~pop~~ FLO 20 BO + trw
 did NT P 57BO + trw
 24 hrs P 37BO + trw 24 hrs
 P 20BO + trw 24 hrs
 P 19BO + trw 24 hrs JAN 29 '58
 P 20BO NW 24 hrs FEB 9 '58
 \$ 1 1/2 BOPH 3 hrs thru tbg
 \$ 5-6' M + 1 2/3 BU OB
 FU 600' oil overnight
 pop P 15 BOPD + 1 1/2 gw
 3 days FEB 12 '58 P 20 BOPD +
 1/2 gw FEB 13 '58
 P 10 BOPD w increasing slight
 P 8-10 BOPD 8 gw
 MAR 19 '58 P 10 BOPD + 10 gw
 P 7 BOPD + 15 gw APR 9 '58
 APR 15 '58 APR 23 '58 P 6 BOPD + 15 gw
 MAY 7 '58 MAY 21 '58 MAY 28 '58
 JUN 3 '58 JUN 11 '58 JUN 18 '58 To Acidize
 JUN 25 '58 (1/2) P 120 BO + 10 gw
 24 hrs phy P 110 BO + 10 gw
 24 hrs