

Barber

KANSAS


SECTION 21 TOWNSHIP 30S RANGE 15W

WELL NO. #4 Walker

COMPANY Aylward Drlg. Co.

NORTH

C E/2 SW NE

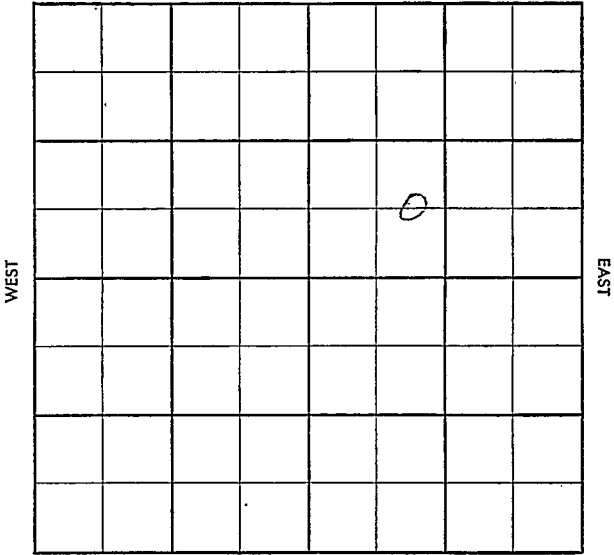

SOUTH

~~St. Lawrence~~ ~~Fast~~

County Barber Elev. _____
 Sec. 21 Twp. 30 Rge. 15W
 Company Aylward Drlg. Co.
 Farm Name Walker No. 4

TOPS	DEPTH	LOG	DATUM
Anh.			
Tp.			
H.			
Tr.			
Dg.			
B.L.			
L.			
K.C.			
B.K.C.			
Ce.			
C.			
M.			
M.			
K.			
Mz.			
Mq.			
V.			
S.			
S.			
A.			
R.			
Pf.			
G.			
T.D.			

Loc. in Sec. C E/2 SW NE

Geol. _____
 Contr. _____
Co. Tools #2

Pool _____
Turkey Creek E.

FIRST REPORT

30 58

Date Comm. _____
RURT

Co.
Lse.
No.
Sec.
T.
R.

Low 574
 73
 Co. Fact

9-513-B

County Barber Elev 1778 of 1781 RB
 Sec. 21 Twp. 30 Rge. 15W
 Company Harward Drig. Co.
 Farm Name Walker No. 4

TOPS	DEPTH	LOG	DATUM
Anh.			
To	3700		
Tr.			
Bg.	3742		
Bgl.	3991		
Lf.			
K.D.	4288		
B.K.C. <u>Massoy</u>	4320		
Co.			
C. <u>Cherty</u>	4424		
M.			
M.			
K.			
Mz.			
Mg.			
V. <u>Cherty</u>	4485		
S.			
S.			
A.			
R.			
Pf.			
G.			
T.D.	4507		

Loc. in Sec. C E/2 SW NE
 Geol.
 Contr.
 Co. Tools #2
 Pool
Turkey Creek

COMPLETE
 SEP 17 '58

Date Comm. 7-29-58 858 800/567
 ELEV 6' 3120 AUG 13 '58 4072 AUG 20 '58
 Top DST 4488-4507 1 hr 120
60' SOCW 60' W
BHP 141520" TD 4507
5" 4490 3/4 493 1/2 - 4504 1/2
757g AUG 27 '58 \$ 6280 +
33 BW 2 1/2 hrs PDP
SEP 3 '58 SEP 10 '58 SEP 17 '58 etc 11730 PDP
+ 3390W SW 36°