


Section 21 Township 30 Range 14-W

Well No. #1 Werner

Company Great Lakes Carbon

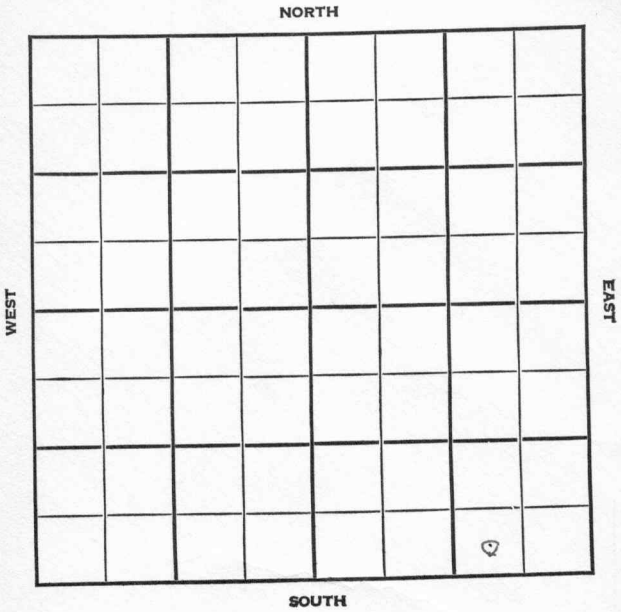

KANSAS

Barber

Sec. 21 Twp. 30 R. 14W ✓

Well No. #1 Werner Farm

Great Lakes Carbon Company

Wildcat


 Ft. from N. Line

330' Ft. from S. Line

990' Ft. from E. Line

 Ft. from W. Line

SW SE SE

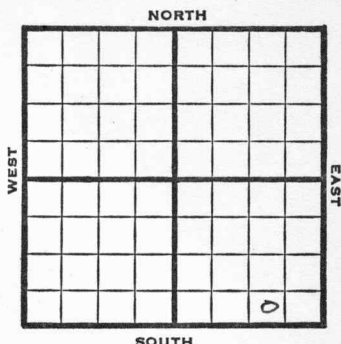

1948 **Eli 1905'** REPORT

7/8	Location
7/14	RUR
7/21	8"@ 824'
	Drlg 2745'
7/28	Drlg 3905'
8/4	Lansing 3987'
	Drlg. 4582'
8/11	BKC 4322'
	Conglomerate 4484'
	Viola 4506'
	Simpson Sd 4582'
	TD 4594'
	5"@ 4582'
8/18	5 M Gas
8/25	TD 4610' 4½ M Gas
9/1	PB 4594'
9/8	"
9/14	"
9/21	"
9/29	"
10/6	"
10/13	"

OVER

1948

10/20 TD 4610'
Simpson 4582'
5"@ 4582'
4½ M Gas
1400# R Pr.
Comp

COMPLETED

Map No. _____ Sec. 21 Twp. 30 R. 14W

Well No. 1 Werner

Great Lakes Carbon Company

FIRST REPORT Contractor

SW SE SE

SECTION PLAT

_____ Ft. from N. Line

330 Ft. from S. Line

990 Ft. from E. Line

_____ Ft. from W. Line

Barber County

Location X

Rig up _____

Drilling and Remarks:

RECORD

Cased _____ in., _____ ft.

Sand _____

Gas _____

Oil _____

Total Depth _____

PRODUCTION

1st 24 hrs. Nat. _____

1st 24 hrs. after shot _____

Gas _____ Cu. Ft.

Dry Hole _____

Abandoned _____

Date

JUL 8 1948 19 S. J. LEWIS Scout

Wildcat

Form No. 204 (Rev. 1-18-1918)
Kansas

14W

30

Twp.

21

Sec.

Map No.


Company


Great Lakes Carbon

Contractor

REPORT

25 25 25

SECTION PLAT

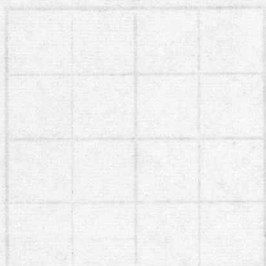

Fe. from N. line
250 Fe. from S. line
250 Fe. from E. line
Fe. from W. line


RECORD

Location

Case No. in

Misc. Small Maps

Cards *[Signature]*

Tracing *[Signature]*

France Map *[Signature]*

Scarborough Map *[Signature]*

Pierce Map

Geological Dept.

Pierce Plat Book

Date


25 25 25

Map No. 92 Sec. 21 Twp. 30 R. 14WWell No. 1 WernerGreat Lakes Carbon Company

COMPLETE

Contractor

SW SE SE

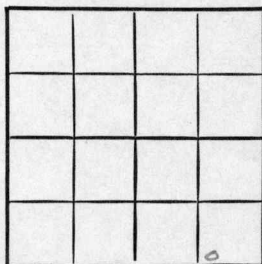E 11905
SECTION PLAT Ft. from N. Line330 Ft. from S. Line990 Ft. from E. Line Ft. from W. LineBarber CountyLocation Rig up

Drilling and Remarks:

Drill 40825" C 40824 1/2 M Gas1400* R 12

RECORD

Cased in., ft.Sand Gas Oil Total Depth 4618

PRODUCTION

1st 24 hrs. Nat. 1st 24 hrs. after shot Gas Cu. Ft.Dry Hole Abandoned

Date

OCT 20 1948 19S. J. LEWIS

Scout


Map No. _____ Sec. _____ Twp. _____ R. _____

Well No. _____

Company _____

COMPLETE

Contractor _____

SECTION PLAT

_____ Ft. from N. Line

_____ Ft. from S. Line

_____ Ft. from E. Line

_____ Ft. from W. Line

RECORD

Cased _____
Sand _____
Gas _____
Oil _____
Total Depth _____

Location _____

Rig up _____

Drilling and Remarks _____

Misc. Small Maps _____
Cards _____
Tracing _____
France Map _____
Scarborough Map _____
Pierce Map _____
Geological Dept. _____
Pierce Plat Book _____

Date _____

OCT 20 1948