

KANSAS


FORM 51 5M 11-44 PETROL

Barber

Section 21 Township 30 Range 13-W

Well No. #1 Lemon

Company Driller's Gas et al

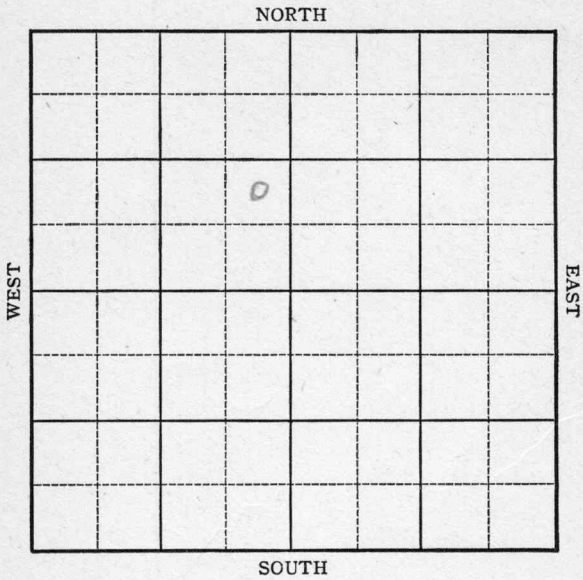

Sec. 21 Twp. 30 R. 13W

Well No. #1 Lemon Farm

Driller's Gas et al Company

Marjorie


_____ Ft. from N. Line

990 Ft. from S. Line

330 Ft. from E. Line

_____ Ft. from W. Line

NE SE NW

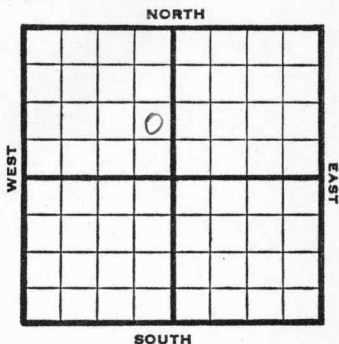

1946

Elev. 1786' REPORT

- 1/16 Location
- 1/24 1000' run casing.
- 1/31 8" - 988' Drlg. 1978'
- 2/7 Drlg. 3565'
- 2/14 Drlg. 4419'
- 2/21 Magu 4435' T.D. 4438'
- 7" - 4437' RUST.
- 2/28 " " "
- 3/7 T.D. 4447' 5000 acid.
- 8 M gas.
- 3/14 "
- 3/20 Maguoketa 4435
- 7" @ 4437
- 5000 acid.
- TD 4447
- 8,800,000 Gas.
- 1380# R Pr.

COMPLETED

