


Section 21 Township 30 Range 13W

Well No. #1 Lemon "B"

Company Lion Oil Ref.

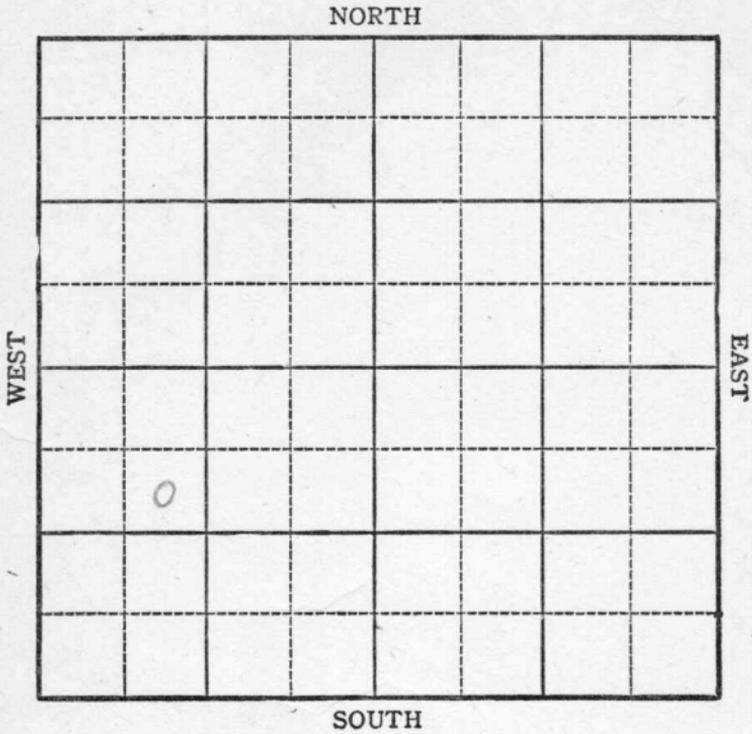

Sec. 21 Twp. 30 R. 13W

Well No. #1 Lemon "B" Farm _____

Lion Oil Ref. Company _____


Wildcat

990 Ft. from N. Line

_____ Ft. from S. Line

_____ Ft. from E. Line

990 Ft. from W. Line

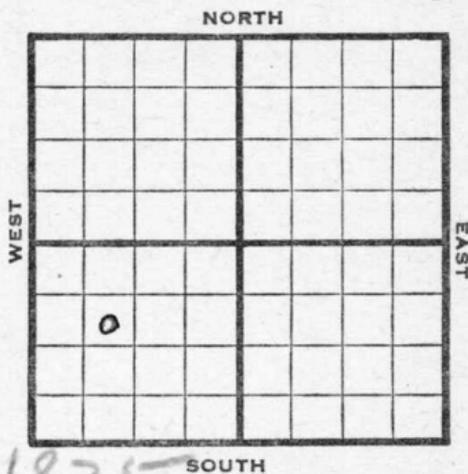

SE NW SW Elev. 1825 SOUTH

1945

R E P O R T

2/14 Location
 2/21 Spud
 2/28 8" @ 726 WOC
 3/7 Drlg 2100
 3/14 Drlg 3860
 3/23 Douglas 3780
 Lans 3899
 Miss 4361
 Drlg. 4553 S Gas
 3/29 Simp sd 4608
 Arb 4678
 TD 4701
 5" @ 4681 RUST
 4/5 Simp sd 4608
 Arb 4678
 TD 4701
 5" @ 4681
 4/12 48 shots 447-495 S Gas
 4/20 8000 acid. 13 M Gas
 4/25 Miss 4361
 Arb. 4678
 5" @ 4681
 TD 4701
 Perf. Miss 18000 acid.
 13 M Gas

COMPLETED

Pool Name Wildcat

Map No. K-92 Sec. 21 Twp. 30 R. 13W

Well No. 1 Lemon "B"

Lion Oil Ref. Company

FIRST REPORT

Contractor

SE NW SW


SECTION PLAT

990 Ft. from N. Line

 Ft. from S. Line

 Ft. from E. Line

990 Ft. from W. Line

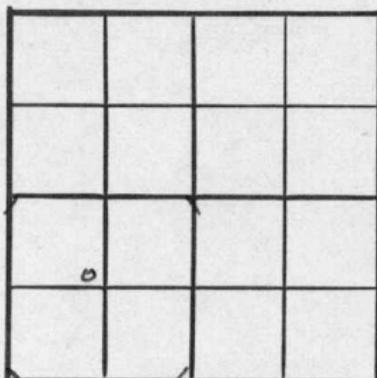

Barber

Location X

Rig up

Drilling and Remarks:

RECORD

Cased in., ft.

Sand

Gas

Oil

Total Depth

PRODUCTION

1st 24 hrs. Nat.

1st 24 hrs. after shot

Gas Cu. Ft.

Dry Hole

Abandoned

Date

FEB 14 1945

19

S. J. LEWIS

Scout

Pool Name Marjorie

Map No. 92 Sec. 21 Twp. 30 R. 13W

Well No. 1 Lemon "B"

Lion Oil Ref. Company

COMPLETED

Contractor

SE NW SW


E. 1825.
SECTION PLAT

990 Ft. from N. Line

_____ Ft. from S. Line

_____ Ft. from E. Line

990 Ft. from W. Line

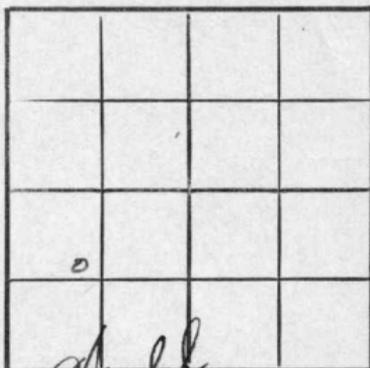

Barber County

RECORD

Location _____

Rig up _____

Drilling and Remarks:

Miss 4861
Ar 4678
5104687
Prof Miss
18000 acid
13 N Gas

Cased _____ in., _____ ft.

Sand _____

Gas _____

Oil _____

Total Depth 4701

PRODUCTION

1st 24 hrs. Nat. _____

1st 24 hrs. after shot _____

Gas _____ Cu. Ft.

Dry Hole _____

Abandoned _____

Date

APR 25 1945 19

S. J. LEWIS Scout