


Haskell

KANSAS

SECTION 21 TOWNSHIP 30 RANGE 34W

WELL NO. #1 Moore

COMPANY Trees Oil

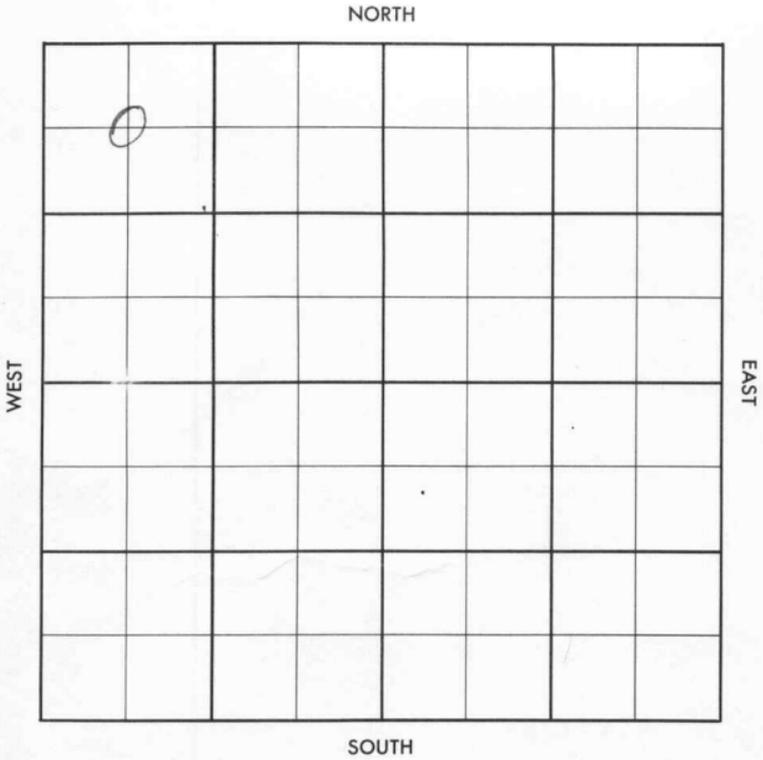

# WILDCAT

FORM 513 SUNRAY

County Haskell Elev. \_\_\_\_\_  
Sec. 21 Twp. 30 Rge. 34W  
Company Trees Oil  
Farm Name Moore No. 1

TOPS	DEPTH	LOG	DATUM	Loc. in Sec.
Anh.				C NW NW
Tp.				Miss. test
H.				
Tr.				
Dg.				
Bl.				
L.				Geol. _____
K.C.				Contr. _____
B.K.C.				
Ce.				Sierra
C.				
M.				Pool
M.				Wildcat
K.				
Mz.				
Me.				
V.				
S.				
S.				
A.				
R.				
PE.				
G.				
T.D.				

o

FIRST REPORT

DEC 12 '36

Date Comm. Colo O & G & United Prod.

Location \_\_\_\_\_

*35*

Co.  
Lse.  
No.  
Sec.  
T.  
R.

2966  
-2609

FORM 513 SUNRAY

County Haskell Elev. 2966  
 Sec. 21 Twp. 30 Rge. 34W  
 Company Trees Oil  
 Farm Name Moore No. 1

TOPS	DEPTH	LOG	DATUM	Loc. in Sec.
Anh.	1706			C NW NW
Tp.	3260			
H.	4020	3988		Miss. test
Tr.		4060		
Dg.		4138		
Bl.		E		
L.		4202	-1236	Geol.
K.C. <u>Md 117</u>		4788	-1672	
B.K.E. <u>MWSH</u>	5320	5322	-2336	Contr.
Ce.		4962	-1996	
C. <u>Aford</u>		5160	-2196	Sierra
M. <u>M 134</u>		5368-70	-2300	
M. <u>Crest</u>		5525	-2609	Pool
K. <u>L. 27 600</u>		5670	-2784	Wildcat
Mz.				
Ma.				
V.				
S.				
S.				
A.				
R.				
Pe.				
G.				
T.D.	5705			

MAR 27 '57  
COMPLETE

Date Comm. Dec 19 '56 Colo O & G & United Prod.  
 Location DEC 26 '56 ✓  
12-19-56  
7 7/8" @ 1040 D 1714 JAN 2 '57 D 2630  
D 4617 X DST 5350-80  
up 10" PKr Failed G/5" ga. 1 Mill.  
CFG rec 1500' oil (38°) + 485'  
H/O GCM + 540' Md. FP 640-95059  
no SIP crg ahead @ 5380-5420  
JAN 23 '57 5 1/2 5467/250 PF 5370-80

Flwd 14 Boph nolw + 1 Mill CFG  
 JAN 03 '57 FEB 05 '57 Flwd 275 Bo nolw  
 1/2" ch 24 hrs FTP 50# + est  
 1 Mill CFG FEB 13 '57 FEB 20 '57 ✓ FEB 27 '57  
 Frac Top MAR 06 '57 MAR 13 '57 MAR 20 '57 P.  
 11.2 Boph 17 hrs nolw wopst  
 U. p. called 8:05 5670 MAR 27 '57  
 Ph & E Flw 215 Bopd nolw  
 gran 38°