

Haskell


KANSAS

SECTION 21 TOWNSHIP 30 RANGE 34W

WELL NO. #2 Moore

COMPANY Trees Oil

NORTH C SE NW

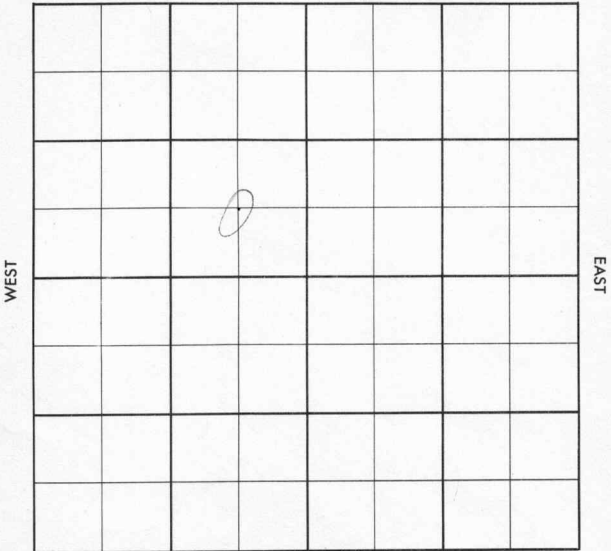

SOUTH

Date Comm.	1-31-57	Sec.
	1740' reaming hole	

~~35~~

35

County Haskell Elev. 2974
 Sec. 21 Twp. 30 Rge. 34W
 Company Trees Oil
 Farm Name Moore No. 2

TOPS	DEPTH	LOG	DATUM	Loc. in Sec.
Anh. <u>Helm</u>		<u>2560</u>		C SE NW
Tr.				Miss. test
H.		<u>4015</u>		
Dg.				
Bl.				
L.		<u>4140</u>		Geol.
M.C. <u>Martin</u>		<u>4808</u>		Contr.
B.K.C.				
Ce.				Sierra
C.				
M. <u>wash.</u>		<u>5340</u>		Pool
M. <u>Chester</u>		<u>5523</u>		Satanta
K.				
Mz.				
M. <u>St Gen</u>	<u>5832</u>	<u>5793</u>		
V. <u>St Louis</u>	<u>5938</u>	<u>6019</u>		
S.				
S.				
A.				
R.				
PE.				
G.				
TD.	<u>6058</u>			

MAR 20 '57
 0
 ABANDONED

Date Comm. 1-31-57
1740' reaming hole FEB 13 '57 8 5/8 1742
1700 3/70 FEB 20 '57 4570 FEB 27 '57
ced 5388-5433 mc 45' Fishing
@ 5560 MAR 6 '57 MAR 13 '57 MAR 20 '57

D & A (H&H)