

Kingman

KANSAS

SECTION 21 TOWNSHIP 30S RANGE 9W

WELL NO. #1^P Hawley

COMPANY Sunray Mid-Continent Oil Co.

NORTH				NE NE NW			
			0				

WEST EAST

SOUTH


SEC.	TWP.	R.
21	30 S	9 W

WELL NO. # 1 P. Hawley FARM

COMPANY Sunray Mid-Continent (DEVELOPMENT)

CONTRACTOR Stickle Drlg.
Spivey-Grabs Field.

330 FT. FROM N. LINE
FT. FROM S. LINE
330 FT. FROM E. LINE
FT. FROM W. LINE

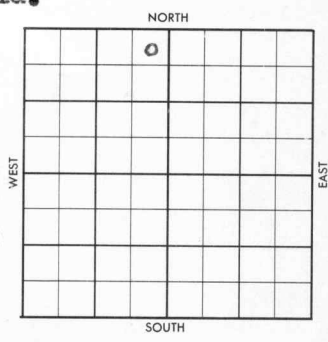

of NW/4
NE NE NW

	ELEVATION	REPORT
1958		
	4300'	Miss. Test
2/11	MIRT	(FR Tkt) (DR#29)
2/12	Spudded 2-11-58	
	TD 310'	Rng. csg.
2/13	TD 310'	WOC. 8-5/8" @ 308'
2/14	Drlg. 1520'	
2/17	Drlg. 2835'	
2/18	TD 3090'	Fishing for drill collar.
2/19	Drlg. 3220'	
2/20	Drlg. 3400'	
2/21	Drlg. 3635'	
2/24	Drlg. 3983'	
2/25	Drlg. 4107'	
2/26	Drlg. 4225'	
2/27	TD 4320'	DST 4295-4320', open 1 hr, 50 MCF 24 hrs. rate.
2/28	TD 4400'	P & A (DR#42)

27
~~Rochester~~

County Kingman Elev. _____
 Sec. 21 Twp. 30 Rge. 9W
 Company Sunray Mid-Continent
 Farm Name Hawley No. 1

TOPS	DEPTH	LOG	DATUM
Anh.			
Tp.			
H.			
Tr.			
Dg.			
B.L.			
L.			
K.C.			
B.K.C.			
Ce.			
C.			
M.			
M.			
K.			
Mz.			
Mq.			
V.			
S.			
S.			
A.			
R.			
Pf.			
G.			
T.D.			

Loc. in Sec. _____

NE NE NW

Geol. _____

Contr. _____

Stickle Drlg.

Pool _____

Spivey-Grabs

Date Comm. _____

MIRT

FEB 17 1958

M. M.

Rochester

513-B

Co.

County Kingman Elev. 16670' L.P.R.
Sec. 21 Twp. 30 Rge. 9W
Sunray Mid-Continent
Hawley No. 1

TOPS	DEPTH	LOG	DATUM
Anh.			
Tp.			
H.			
Tr.			
Dg.			
B.L.			
L.			
K.C.	<u>5644</u>		
B.K.C.			
Ce.			
C.			
M.	<u>4307</u>		
M. <u>Li</u>	<u>4396</u>		
K.			
Mz.			
Mq.			
V.			
S.			
S.			
A.			
R.			
Pf.			
G.			
T.D.	<u>4400</u>		

Loc. in Sec. NE NE NW

Geol. _____
Contr. _____
Stickle Drlg.

Pool _____
Spivey-Grabs



ABANDONED

MAR 5 '58

Date Comm. 2-10-58
MIRT 8 308/300 log 3090

FB26 58 Tops 4107 MAR 3 '58 XPS
Tops DST 4295 4320 60" g/15"
ga 50 MCF rec 50' gem FP 83-
03 IBHP 1637 FBHP 1445 DST
4320-3960" g/60" rec 150'
50 gem 30' n SW FP 37-114
IBHP 1636 FBHP 964 miss Li
4396 TD 4400 ton log
DBA

Lse.

No.

Sec.

T.

R.