
Kingman KANSAS

SECTION 21 TOWNSHIP 30S RANGE 8W

WELL NO. #2-Carrick "B"

COMPANY N C R A

NW SE SW

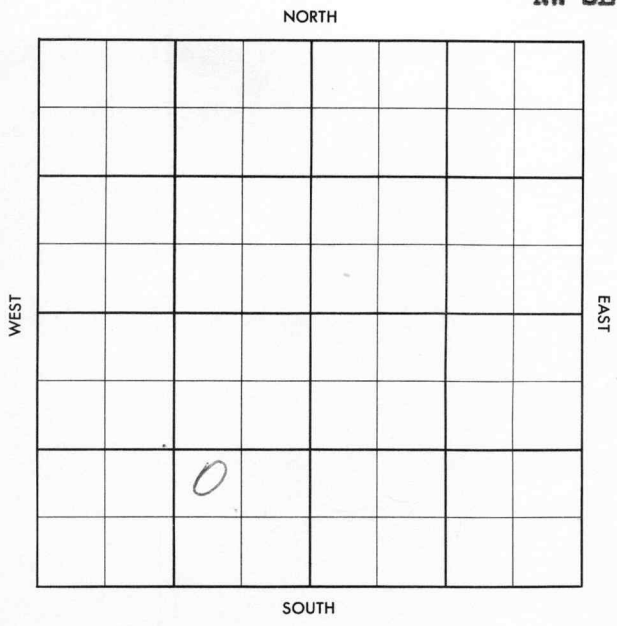

FORM 504-3 SUNRAY

FORM 513 SUNRAY

County Kingman Elev.

Sec. 21 Twp. 30 Rge. 8W

Company N C R A

Farm Name Carrick "B" No. 2

TOPS	DEPTH	LOG	DATUM
Anh.			
Tp.			
H.			
Tr.			
Dg.			
B.L.			
L.			
K.C.			
B.K.C.			
Ce.			
C.			
M.			
M.			
K.			
Mz.			
Mq.			
V.			
S.			
S.			
A			
R.			
P€.			
G.			
T.D.			

Loc. in Sec. NW SE SW

Geol.

Contr. Virginia

Pool Spivey-Grabs

JUL 24 '57

FIRST REPORT

Date Comm.

Location

27

Co. Lse. No. Sec. T. R.

FORM 513 SUNRAY

County Kingman Elev. 1589 Co.

Sec. 21 Twp. 30 Rge. 8W

Company N C R A

Farm Name Carrick "B" No. 2

TOPS	DEPTH	LOG	DATUM
Anh.			
Tp.			
H.	3287		
Tr.	3300		
Dg.	3321		
Bl.			
L.	3505		
K.C.			
B.K.C.	4204		
Ce.			
C.			
M.	4255		
M.			
K.			
Mz.			
Mo.			
V.			
S.			
S.			
A			
R.			
P€.			
G.			
T.D.	4370		

Loc. in Sec. NW SE SW

Geol.

Contr. Virginia Lse.

Pool Spivey-Grabs

ABANDONED

AUG 14 '57

No.

Date Comm.

Location AUG 31 '57 7-27-57 Sec.

262/140 ND 1990 AUG 9 '57 ND 3840

AUG 14 '57 DST 4257-76. 1 hr G/4"

ga 120 MCFG FP 30-30 BHP

1565/20" DST 4278-4370 T.

2 hrs rec 60' Md BHP 1301/20"

DC'A R.