
FORM 51 10M 8-47

KANSAS Grant

Section 21 Township 30 Range 35-W

Well No. #1 Radcliff

Company United Prod.

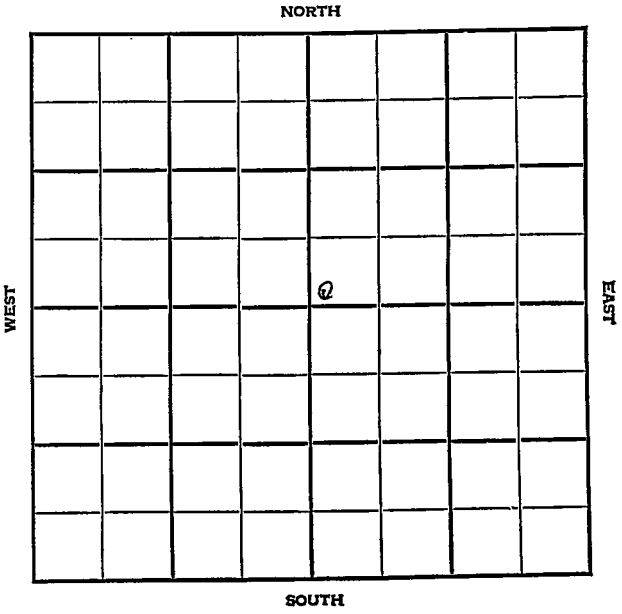

FORM 252-A
5M 4-48 PETROL

KANSAS Grant

Sec. 21 Twp. 30 R. 35W

Well No. #1 Radcliff Farm

United Prod. Company

Hugoton Pool


_____ Ft. from N. Line

100' Ft. from S. Line

_____ Ft. from E. Line

100' Ft. from W. Line

SW NE

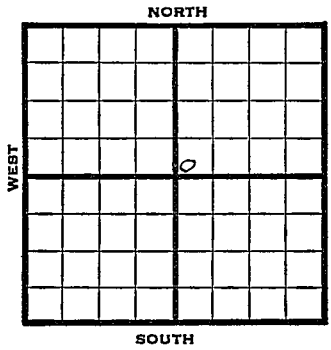

1948	Eli 2864' REPORT
7/21	Location
7/28	10"@ 439' TD 2400' 7"@ 2397'
8/4	Drlg. 2573'
8/11	TD 2596' 216' of 5" Peff Liner @ 2596' 2000 acid
8/18	12000 acid
8/25	"
9/1	TD 2596' 7"@ 2397' 216' of 5" perf liner @ 2596' 14000 acid 18 M Gas 400# R Pr. Comp COMPLETED

Form 26—200 Bks.—1-48—Palace

Kansas

Hugoton Pool

Map No. _____ Sec. 21 Twp. 30 R. 35W

Well No. 1 Radcliff


United Prod. Company

IRST REPORT

Contractor

SW NE

SECTION PLAT

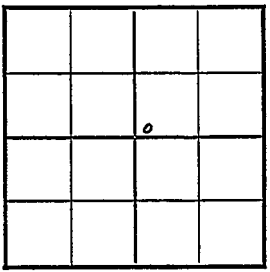

_____ Ft. from N. Line

100 Ft. from S. Line

_____ Ft. from E. Line

100 Ft. from W. Line

~~Grant County~~

Location X

Rig up

Drilling and Remarks:

RECORD

Cased _____ in., _____ ft.

Sand

Gas

Oil

Total Depth

PRODUCTION

1st 24 hrs. Nat.

1st 24 hrs. after shot

Gas _____ Cu. Ft.

Dry Hole

Abandoned

Date

JUL 21 1948 19

S. J. LEWIS Scout

Form 27—100 Bks.—4-48—Petrol

Grant County Kansas State

Map No. Sec. 21 Twp. 30 R. 35W

Well No. 1 Radcliff


United Prod. Company

COMPLETE Contractor

SW NE

El. 2824

SECTION PLAT

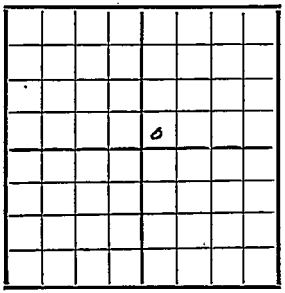

____ Ft. from N. Line

100 Ft. from S. Line

____ Ft. from E. Line

100 Ft. from W. Line

Hugoton Pool

Remarks:

TD 2596

7" @ 2387

216 sx 5" Pay liner @ 2596

14000 gal acid

ISIP Gas

400# RP

Date SEP 1 1948

Scout S. J. LEWIS